

CERTIFIED LAND CORNER RESTORATION

Index No. **28**

State of Wisconsin

County of Oneida } ss.


I Philip T. Hansen, do hereby certify that on the 8th day of September, 1975, I found evidence of the E-1/16 corner of Sections 20 and 29 Township 36 North, Range 10 East, Fourth Principal Meridian, as described hereon; and that from this evidence I established a new monument and accessories as described hereon to perpetuate the original location of this corner.

Resident witnesses:

Glen Barker

Jim Clafflin

T36N, R11E

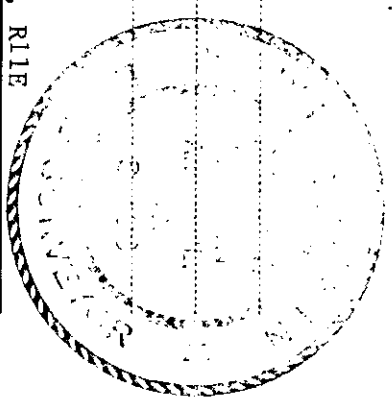

History of original corner establishment:
 Corner established by H.C. Lawrence, Registered Land Surveyor, in 1948. This corner was set by D.H. Vaughan in 1897 and again by Dorr in 1903. No trace of their corners or BT's was found. Lawrence ran transit line from corners 20, 21, 28, and 29, 83.16 chains West to point 70 links South of the section corner.
 Set East-1/16 corner 17 1/2 links North at right angles from 62.37 chains from which high-line pole 1573 bears S43°W, 92 links.


Description of corner evidence found:
 Recovered 4" cedar post, squared and scribed E-1/16 S20, E-1/16 S29, in poor condition.
 Recovered highline pole 1573 - S43°W, 92 links, scribed R0.

Description of monument and accessories: I established to perpetuate the original location of this corner.
 Replaced 4" cedar post with 1 1/2" OD iron pipe with 2" brass cap stamped - S498
 T36N, R11E

NBT - Cedar 10" N63°W 70 links scribed 1/16 BT

E-1/16 S|20 S|29

CPI-1975

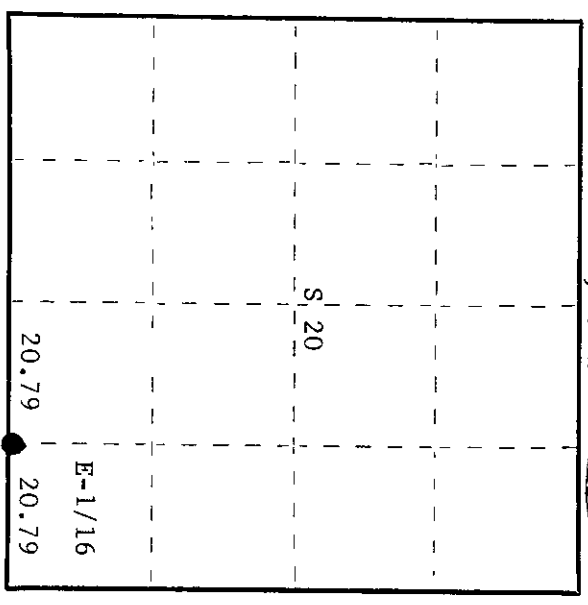

○ = Corner monument restored.

Dated at Rhinelander, Wis. this 18th day of September, 1975.

Signature: *Philip T. Hansen* Title: Registered Land Surveyor Registration No. S-498
 County Surveyor, Registered Land Surveyor, or other duly authorized official

Office of Register of Deeds, County of Oneida
 Instrument was filed in this office for record on the 17th day of September, 1975. I hereby certify that the within at/p o'clock P.M.

Doree LePage Kuehn
 (Register of Deeds)

By: Deputy

3611200010