



CERTIFIED LAND CORNER RESTORATION

Index No. Q-11

State of Wisconsin }
 County of Oneida } ss.

I Phillip T. Hansen 7th, do hereby certify that on the 19 75, I found ~~no evidence of a monument~~ established the SC-1/16 corner of Section 21 Township 36 North, Range 11 East, Fourth Principal Meridian, as described hereon; and that from this evidence I established a new monument and accessories as described hereon to perpetuate the original location of this corner.

Resident witnesses:

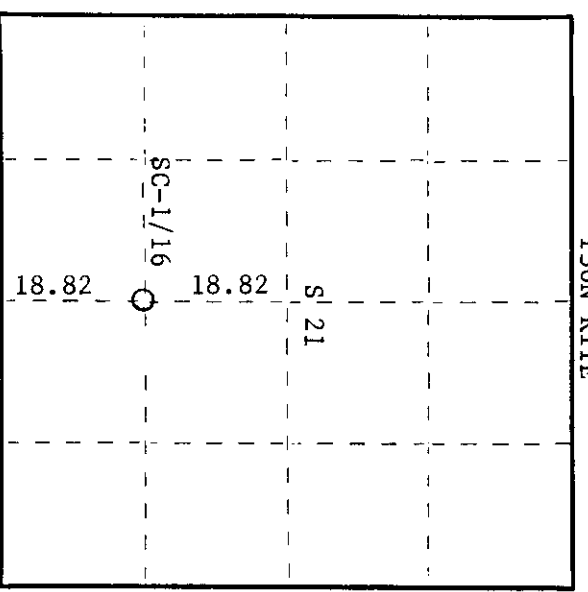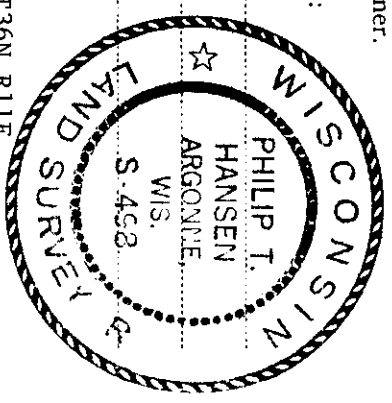

○ = Corner monument restored.

History of original corner establishment:

Description of corner evidence found:
 No evidence of previously established corner.

Description of monument and accessories I established to perpetuate the original location of this corner.
 From established C-1/4 corner and S-1/4 corner between Sections 21 and 28. Set a 1-1/2" O.D. galvanized iron pipe with brass cap S3°E, 18.82 chains, equidistant between them.
 Stamped -

- NBT's - White birch 6" N73°E 86.2 links scribed 1/16 BT T36N R11E S498
- White birch 7" S84°E 37.2 links scribed 1/16 BT

SC-1/16 S 21
 CPI-1975

Dated at Rhineland, Wis. this 7th day of May, 1975.

Signature Phillip T. Hansen Title Registered Land Surveyor Registration No. S-498
 (County Surveyor, Registered Land Surveyor, or other duly authorized official)

Office of Register of Deeds, County of Oneida
 Instrument was filed in this office for record on the 1st day of October, 1975
 at 3:00 o'clock P.M. I hereby certify that the within

Toni Berge Kuehn
 (Register of Deeds)

By: Deputy

020121198