

CERTIFIED LAND CORNER RESTORATION



Index No. P-11

History of original corner establishment:

State of Wisconsin } ss.
 County of Oneida }

I Philip T. Hansen, do hereby certify that on the 19th day of ~~November~~ October, 1975, I ~~found~~ found ~~no evidence of~~ evidence of establishment established the C-1/4 corner of Section 21 Township 36 North, Range 11 East, Fourth Principal Meridian, as described hereon; and that from this evidence I established a new monument and accessories as described hereon to perpetuate the original location of this corner.

Resident witnesses:

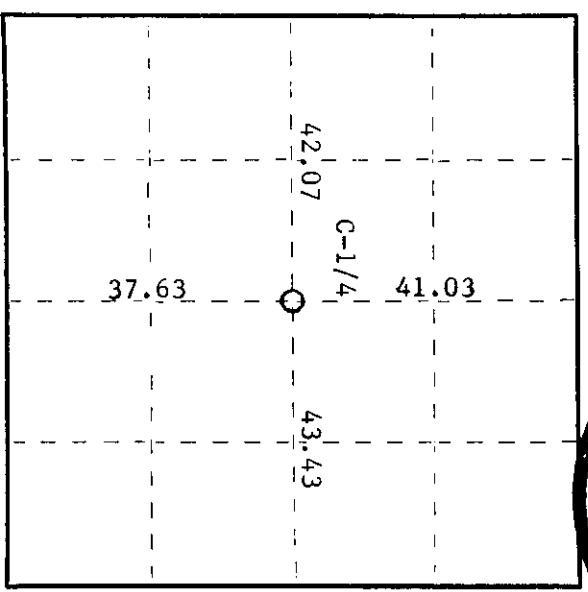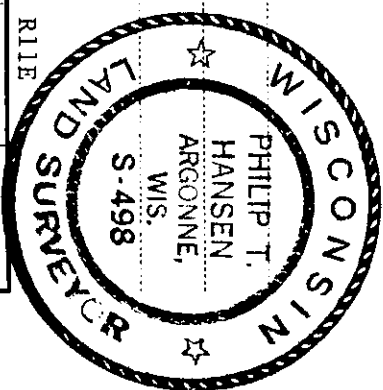

○ = Corner monument restored.

Description of corner evidence found:
 No evidence of established corner recovered.

Description of monument and accessories I established to perpetuate the original location of this corner.

Ran random lines and traverse to establish the North-South and East-West 1/4 lines to determine the intersection or C-1/4 corner. Set a 2-1/2" iron pipe with brass cap at point 41.03 chains South 3° East of N-1/4 corner, 37.63 chains North 3° West of S-1/4 corner, 43.43 chains S86°22'W of East-1/4 corner, and 42.07 chains N86°32'E of W-1/4 corner. Stamped -

NBT's - 1-1/2" O.D. Iron pipe w/brass cap stamped WC S54°W 58 links S498
 1-1/2" O.D. Iron pipe w/brass cap stamped WC N27°E 61 links T36N R11E

C-1/4 S 21
 CPI-1975

Dated at Rhinelander, Wis., this 7th day of May, 1975.

Signature Philip T. Hansen Title Registered Land Surveyor Registration No. S-498
 (County Surveyor, Registered Land Surveyor, or other duly authorized official)

Office of Register of Deeds, County of Oneida. I hereby certify that the within instrument was filed in this office for record on the 1st day of October, 1975, at 3:00 o'clock P.M.

Donna Savage Fuchs
 (Register of Deeds)

By: Deputy

36112/2020