

CERTIFIED LAND CORNER RESTORATION

Index No. P-10

State of Wisconsin


County of Oneida } ss.

History of original corner establishment:

I Phillip T. Hansen do hereby certify that on the 7th day of May, 19 75, I ~~relocated~~ re-established ~~established~~ established WC-1/16 corner of Section 21 Township 36 North, Range 11 East, Fourth Principal Meridian, as described hereon; and that from this evidence I established a new monument and accessories as described hereon to perpetuate the original location of this corner.

Description of corner evidence found:
No evidence of established corner found.

Resident witnesses:

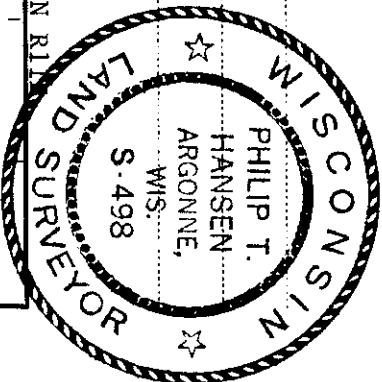

Description of monument and accessories I established to perpetuate the original location of this corner.

Set 1-1/2" O.D. x 5' galvanized iron pipe with brass cap equidistant between established W-1/4 corner between Sections 20 and 21 and the C-1/4 corner. Set at 21.72 chains S 86° 22' W (mag.). Corner stamped -

NBT's - Popple 6" N75°W 22.2 links scribed 1/16 BT S498
Black spruce 5" N63°E 55.5 links scribed 1/16 BT T36N R11E

WC-1/16 S 21

CPI-1975

Dated at Rhinelander, Wis., this 7th day of May, 19 75

Signature Phillip T. Hansen Title Registered Land Surveyor Registration No. S-498
(County Surveyor, Registered Land Surveyor, or other duly authorized official)

Office of Register of Deeds, County of Oneida
Instrument was filed in this office for record on the 7th day of May, 19 75
at 3:00 o'clock P. M. I hereby certify that the within

Doris Venage Smith
(Register of Deeds)

By: _____ Deputy

○ = Corner monument restored.

3611212030