
location of this corner. as described hereon to perpetuate the original as described hereon; and that from this evidence corner of 522, 23, 26, 27 certify that on the 23rd I established a new monument and accessories Township... Philip T. Hansen LL Last, Fourth Principal Meridian section, 19.76 , I found, North, Range do herebyday

Jim Claflin Resident witnesses:

herb kagoner SURVEYOR

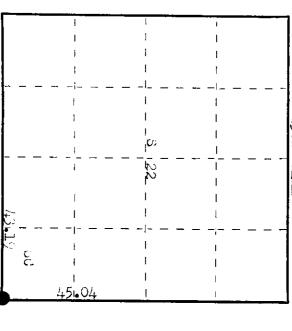

O = Corner monument restored.

Ву

.Deputy

CERTIFIED LAND CORNER RESTORATION

History of original corner establishment: Original Corner established by Win. E. Dougherty, Deputy Surveyor, in 1859 from which Spruce 6" bears 3 61° a 25 links and Tamarack 8" bears N 75° a 24 links.

This corner according to D.H. Vaughan, County Surveyor, was set by Monsell by proportional

measure. Man random line east from recovered & corner 43.19 chains to someone's corner from which Tamarack 10" bears 341° . 32 links, is 4.52 chains south. At 21.50 he offset 2.31 chains south and found old picket line. Man east and at west side of Leith Lake, searched for M.C. - found nothing. On east side of Leith Lake found original DT, Tamarack 10" (over) O Description of corner evidence found: Corner re-established by H.C. Lawrence, Registered Land Surveyor, in 1948. Set by proportional measurement.

Recovered 4" squared hemlock post in poor condition scribed 523, T36N allE, sec. 26, 527,

No BT's recovered.

Tamarack St. 2770 2 51.3 links	IBT's - Laple 14" > 76° = 53.0 links, scribed >0 oT. Taple 6" > 120° = 59.0 links	Monument projects 24" above ground.	in cap ind base). Jas stimped.	Description of monument and accessories I established to perpetuate the original location of this corner
	C of		nument (aluminum with alloy cap a magnet	tuate the original location of this corner.

Loqument and bT's painted blue.

at 100 o'clock I M. Lorus Colitage (Register	Office of Register of instrument was file	Signature Juil	Dated at thinelander
Lower Collection M. (Register of Doctos)	Office of Register of Deeds, County of 418143 , I hereby certify that the within instrument was filed in this office for record on the 2201 day of x15 to 1976.	Signature Julia / Shane Title registered wand ourve, or County Surveyor, Registered Land Surveyor, or other duly authorized official)	elander , Wis., this 20th
	medida the 2200	Title registered many d Surveyor, or other duly autho	
	day of X & L. L. L.	Re	day ofսեր
	rify that the within	Registration No. 3-498	, 19 <u>. 76</u>

* H 19° £ 27 links, down and hearly buried in muck. He drove a tamarack stake behind stump of this BT.

Original Tamarack 8" 5 71° £ 13 links only a stump. From these two BT's, intersected, dug and recovered point of old heander post in proper place. Fade HBT - Tamarack 9" 5 71° £ 38 links. This post is 2.35 chains west of Corner. The 1/4 Corner, £ 1/16 Corner and two heander Corners set are on a straight line, but the Section Corner is 30 links south of the projected straight line.