



CERTIFIED LAND CORNER RESTORATION

Index No. **Q-17**

State of Wisconsin }
County of Oneida } ss.

I Phillip T. Hansen, do hereby certify that on the 21st day of July, 1976, I found evidence of the S 1/16 corner of Section 22 & 23 Township 36 North, Range 11 East, Fourth Principal Meridian, as described hereon; and that from this evidence I established a new monument and accessories as described hereon to perpetuate the original location of this corner.

Resident witnesses:
Jim Claffin
Herb Wagoner

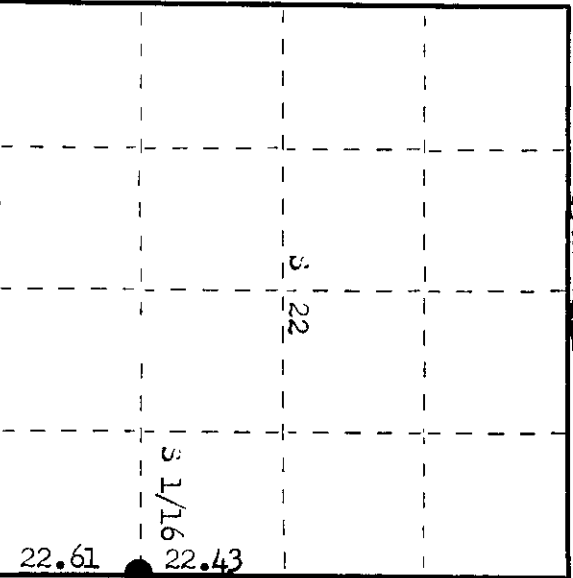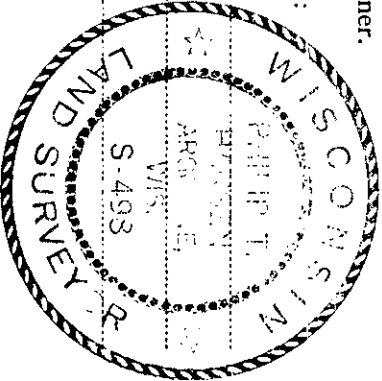

O = Corner monument restored.

History of original corner establishment:

Corner established by D.H. Vaughan, County Surveyor, in 1901. Set wood post and marked BT - Sugar 6" N 58° E 19 1/2 lks.

This corner recovered by H.C. Lawrence, Registered Land Surveyor, in 1948. Recovered remains of Vaughan's post and recovered sugar 6".

Set new hemlock post and marked NBT's - Y.Birch 16" S 29° W 22 lks; Elm 16" S 69° E 64 1/2 lks.

Description of corner evidence found:

Recovered 5" squared hemlock post, scribed S 1/16 S 22, S 23 in poor condition. There was a rock cairn around base of post.

Recovered UBT - Y.Birch 16" (20") S 29° W 22.0 lks, scribed S 1/16 S 22 BT, Elm 16" (stump) S 69° E 64.5 lks.

Description of monument and accessories I established to perpetuate the original location of this corner.

replaced 5" hemlock post with 1 1/2" OD iron pipe with 2" brass cap stamped - Monument projects 24" above ground.

NBT - Sugar 12" N 17° E 38.6 lks, scribed 1/16 BT, Sugar 8" N 74° E 20.3 lks, scribed 1/16 BT.

Corner is 1 chain south of an old logging road, which runs S. Monument and BT's painted blue.

S 498

T36N R11E

22 | 23

S 1/16

GPI-1976

Dated at Rhineland, Wis., this 20th day of August, 1976.

Signature: *Phillip T. Hansen* Title: Registered Land Surveyor Registration No. 3498
(County Surveyor, Registered Land Surveyor, or other duly authorized official)

Office of Register of Deeds, County of Oneida. I hereby certify that the within instrument was filed in this office for record on the 21st day of September, 1976 at 1:00 o'clock P.M.

Karen Verga Kuehn
(Register of Deeds)

By: _____ Deputy

00275193