


CERTIFIED LAND CORNER RESTORATION

Index No. **Q-15**

State of Wisconsin } ss.
 County of Oneida }

I Phillip T. Hansen, do hereby
 certify that on the 15th day
 of January, 1976, I found
 evidence of the SC 1/16
 corner of Section 22
 Township 36 North, Range
 11 East, Fourth Principal Meridian,
 as described hereon; and that from this evidence
 I established a new monument and accessories
 as described hereon to perpetuate the original
 location of this corner.

Resident witnesses:
 Jim Clafflin
 Tom Jewell

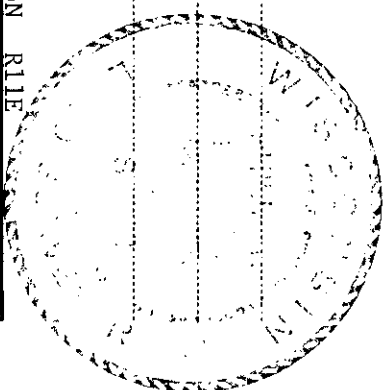

History of original corner establishment: Original corner established by D.H. Vaughan, County Surveyor, in 1901. Set cedar post from which tamarack 12" bears S88°E, 14-3/4 lks. Corner recovered by H.C. Lawrence, Registered Land Surveyor, in 1948. Recovered Vaughan's old post and his tamarack BT. Set new post and marked NBT's - Cedar 14' S57°E, 30 lks. and cedar 10" S63°W, 12-1/2 lks.

Description of corner evidence found: Recovered H.C. Lawrence's 6" cedar post squared, buried in the muck. Was unable to read any scribing. Using intersection of bearings and distances from BT's was able to locate point of his old post.

Recovered OBT's - Cedar 14" S57°E 30 lks. Now dead and leaning, scribed NBT
 Cedar 10" S63°W 12.5 lks. Scribed SC 1/16 NBT
 Tamarack 12" S88°E 14.7 lks. Now a dead stump

Description of monument and accessories I established to perpetuate the original location of this corner.

Replaced 6" cedar post with 1" OD iron pipe with 2" brass cap stamped - S498
 Pipe projects 14" above ground. T36N R11E
 Wooden post set up beside new iron pipe. S 122
 Pipe, post, and BT's painted blue. SC 1/16
 CPT-1976


NBT - Cedar 6" N71°W 35.0 lks. scribed 1/16 BT

Dated at Rhineland, Wis., this 20th day of January, 1976

Signature *Phillip T. Hansen* Title Registered Land Surveyor Registration No. S-498
 (County Surveyor, Registered Land Surveyor, or other duly authorized official)
 Office of Register of Deeds, County of Oneida
 Instrument was filed in this office for record on the 27th day of March, 1976
 at 3:00 o'clock P.M.

George Fisher
 (Register of Deeds)

By _____ Deputy

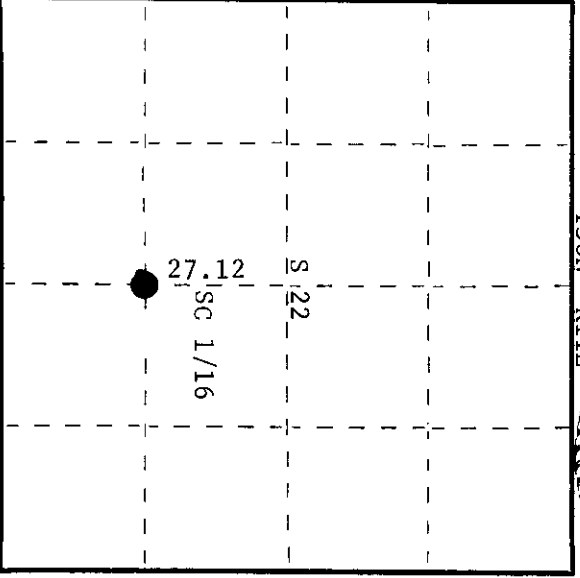

○ = Corner monument restored.

3611221020