

CERTIFIED LAND CORNER RESTORATION

Index No. **P-16**

State of Wisconsin

County of Oneida } ss.

History of original corner establishment: Corner established by H.C. Lawrence, Registered Land Surveyor, in 1948. He ran the E-W 1/4 line, east from C1/4 corner a distance of 43.80 chains to a point 2.70 chains north of 1/4 corner. He was unable to locate any trace of old EC 1/16 corner. Set EC 1/16 post, 5" cedar, 135 lks. south of 21.90 chains. Marked NBT's - Cedar 7", N3-1/2°W, 44-1/2 lks., and maple 14", S16°E, 55 lks. on old road.


I, Philip F. Hansen, do hereby certify that on the 16th day of January, 1976, I found evidence of the EC 1/16 corner of Section 22 Township 36 North, Range 11 East, Fourth Principal Meridian, as described hereon; and that from this evidence I established a new monument and accessories as described hereon to perpetuate the original location of this corner.

Resident witnesses:

Jim Claflin

Tom Jewell

T36N R11E

 


Description of corner evidence found: Recovered 4" squared and scribed cedar post in fair condition scribed EC 1/16, S-22, on all four sides.

Recovered OBT's - Cedar 7" (9") N3°30W (north) 44.5 lks. scribed 1/16 BT
Red maple 14" S16°E (S11°E) 55 lks. scribed 1/16 BT

Description of monument and accessories I established to perpetuate the original location of this corner.

Replaced 4" cedar post with 1" OD iron pipe with 2" brass cap stamped - S498
Pipe projects 24" above ground. T36N R11E
Placed 4" cedar post beside new pipe.

NBT - Cedar 7" N49°E 36.4 lks. scribed 1/16 BT
Pipe, post, and BT's painted blue. S | 22
CPT-1975 EC 1/16

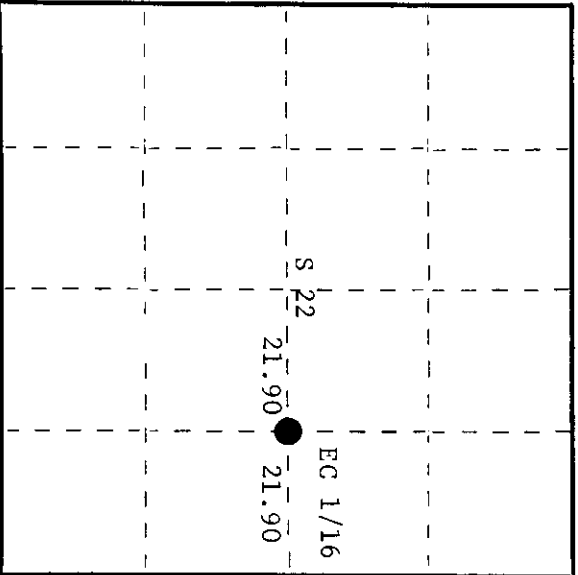

○ = Corner monument restored.

Dated at Rhinelander, Wis., this 20th day of January, 1976.

Signature: *Philip F. Hansen* Title Registered Land Surveyor Registration No. S-498
(County Surveyor, Registered Land Surveyor, or other duly authorized official)

Office of Register of Deeds, County of Oneida
I hereby certify that the within instrument was filed in this office for record on the 9th day of November, 1976, at 10:35 o'clock A.M.

Leona L. Berger
(Register of Deeds)

By: Deputy

2011222010