

U.S. PUBLIC LAND SURVEY MONUMENT RECORD

State of Wisconsin

County of: **ONEIDA**}

I, DANIEL K. PLEOGER, do hereby certify that on the 24th day of August, 2000,

I established the N 1/16 corner between sections 22 and 23

Township **36 North**, Range **11 East**, Fourth Principal Meridian, as described hereon;

and set a new monument and made new accessories as described hereon to perpetuate the original location of this corner:

Description of original monument and accessories and subsequent restorations:

B.F. Dorr, 1899.

Set corner.

Spruce 10" N4 1/2E 30 1/3 lks.

H.C. Lawrence, 1953

Did not find Dorr's corner. Set temporary post.

I established the N 1/16 corner between sections 22 and 23 by normal section subdivision.


Set a 1" x 42" iron pipe with aluminum cap. Found an old squared post broken off at N61E, 5.12 feet, probably Lawrence's.

BTs: 12" white birch N76W 29.03 feet

12" cedar S62E 23.09 feet

9" cedar S17W 36.38 feet

All blazed and scribed 1/16 BT, measured to 60d nail in BTs.

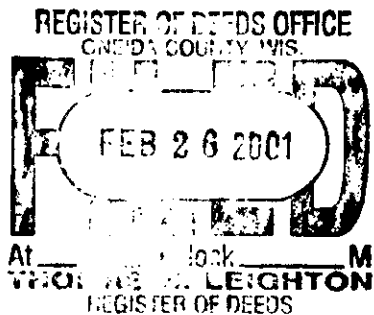

T36N R11E

S	23		

Resident witnesses

Dated at Winter, Wisconsin, this 13th day of February, 2001.

Signature *Daniel K. Pleoger* Title **Registered Land Surveyor**
 Surveyors Registration No. **1537**

Office of _____ County of _____

I hereby certify that the within instrument was filed in this office for record on the _____ day of _____ 19____, and was filed in Book No. _____ Page No. _____ of County Records.

Signature _____ Title _____

Index No. **0-17**

3611223000