

CERTIFIED LAND CORNER RESTORATION

Index No. 0-19

State of Wisconsin

County of Oneida } ss.

History of original corner establishment:
A corner recovered of unknown origin by H.C. Lawrence, Registered Land Surveyor, or. Set a 3" cedar post, and marked NBTs - Hemlock 10" S 56° E 16 links and cedar stump 20" with 4" Yellow Birch grown in center N 55° W 12 links.


I Phillip T. Hansen do hereby certify that on the 5th day of October, 19 76, I found evidence of the NC 1/16 corner of the Section 23 Township 36, North, Range 11 East, Fourth Principal Meridian, as described hereon; and that from this evidence I established a new monument and accessories as described hereon to perpetuate the original location of this corner.

Resident witnesses:


Glenn Barker

Jim Carlson

Herb Wagoner

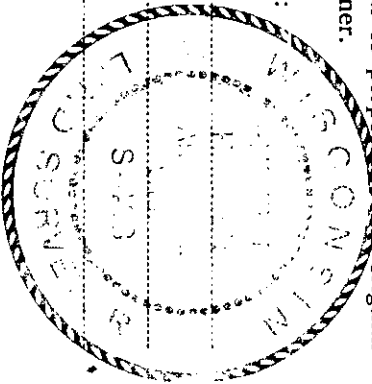

136N R11E

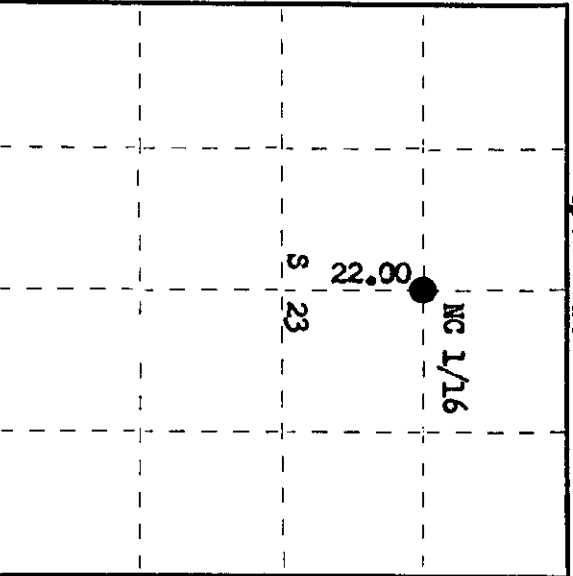

Description of corner evidence found:

Recovered 3" cedar post, squared and scribed NC 1/16 S23 in fair condition. Also an old squared cedar stake laying beside it.
Recovered OBT - cedar stump 20" N 55° W 12 links, scribed BO.
Hemlock 10" S 56° E 15 links, scribed BT.

Description of monument and accessories I established to perpetuate the original location of this corner.

Replaced 3" cedar post with 1 1/2" OD iron pipe with 2" brass cap stamped:
Monument projects 18" above ground.
NBT - Maple 6" N 60° E 11.9 links, scribed 1/16 BT.
Set old post beside new monument.
3498
136N R11E
NC 1/16 S 123
CPI-1976

Dated at Rhinelander, Wis., this 6th day of December, 19 76

Signature Phillip T. Hansen Title Registered Land Surveyor Registration No. S-498
(County Surveyor, Registered Land Surveyor, or other duly authorized official)

Office of Register of Deeds, County of Oneida
at 1:00 o'clock P. M. day of December, 19 76
I hereby certify that the within instrument was filed in this office for record on the 20th day of December, 19 76

Doris Verage Kuehn
(Register of Deeds)

By _____ Deputy

○ = Corner monument restored.