

CERTIFIED LAND CORNER RESTORATION

Index No. **0-25**



State of Wisconsin }
 County of Oneida } ss.

History of original corner establishment: Corner set by surveyor unknown; could possibly have been B.F. Dorr, County Surveyor, in 1899. There are no records to substantiate it.

I Philip T. Hansen, do hereby certify that on the 7th day of October, 1975, I found evidence of the N-1/16 corner of Sections 19 and 24, Township 36, North, Range 11 and 12, East Fourth Principal Meridian, as described hereon; and that from this evidence I established a new monument and accessories as described hereon to perpetuate the original location of this corner.

Resident witnesses:

Glen Barker
 Jim Claflin

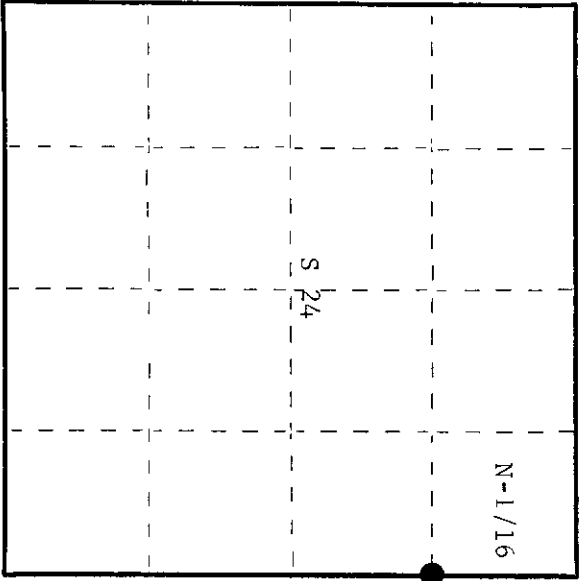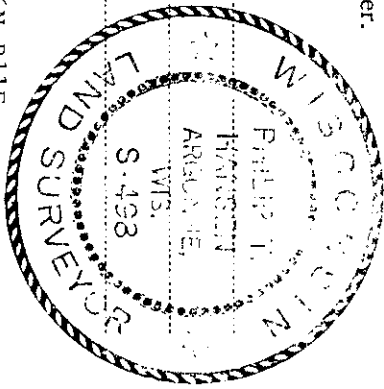

○ = Corner monument restored.

Description of corner evidence found: Recovered very old 3" cedar post, squared and scribed 1/8S, 1/8S, in poor condition, but still standing in place.
 No BT's were visible.

Description of monument and accessories I established to perpetuate the original location of this corner.
 Replaced old cedar post with 1 1/2" O.D. iron pipe with 2" brass cap stamped -

Pipe projects 18" above ground. Set old post beside it. S498 T36N S19 R
 NBT's - Tamarack 9" S66°E 29.3 links, scribed 1/16 BT. 11 N-1/16 S29 S19 R
 B. Spruce 8" S30°W 31.2 links, scribed 1/16 BT. E CPT-1975 E 12

Post and BT's painted blue.

Dated at Rhineland, Wis., this 13th day of October, 1975.

Signature: *Philip T. Hansen* Title: Registered Land Surveyor Registration No. S-498
 County Surveyor, Registered Land Surveyor, or other duly authorized official

Office of Register of Deeds, County of Oneida
 Instrument was filed in this office for record on the 5th day of December, 1975
 at 10:10 o'clock P.M.

Dona Veragey Fuehn
 (Register of Deeds)

By: Deputy

3611243000