

CERTIFIED LAND CORNER RESTORATION


Index No. V-25

State of Wisconsin }
County of Oneida } ss.


I Phillip T. Hansen, do hereby certify that on the 19th day of March, 1976, I found evidence of the Section corner of S 25, 30, 31, 36 Township 36, North, Range 11 & 12 East, Fourth Principal Meridian, as described hereon; and that from this evidence I established a new monument and accessories as described hereon to perpetuate the original location of this corner.

Resident witnesses:

Glen Barker
Jim Clafflin
Herb Wagoner

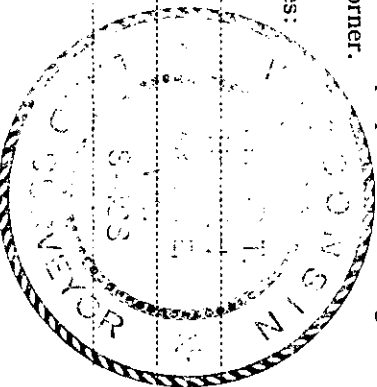

T36N R11E

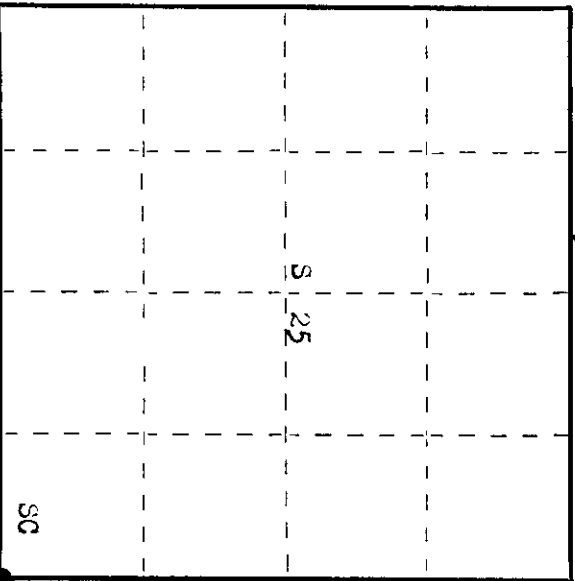

○ = Corner monument restored.

History of original corner establishment:

Original corner established by Hiram C. Fellows, Deputy Surveyor, from which Tamarack 12" bears N 65° E 8 lks. Spruce 8" bears N 70° W 17 lks, spruce 8" bears S 30° W 25 lks and Spruce 8" bears S 40° E 14 lks.

Corner recovered and restored by H. C. Lawrence, registered Land Surveyor, in 1954. Set a new 4" tamarack post. Found two UBTs - Tamarack 8" N 20° W 9 lks and Tamarack 10" S 30° W 30 lks.

Description of corner evidence found:

Recovered 4" tamarack post, squared and scribed S 25, R 11 E, S 36, S 31, T36N, S 30 R12E in fair condition. Also recovered a very old squared tamarack post, scribed S 36, S 31, still visible.
Unable to recover any UBTs because of deep snow.

Description of monument and accessories I established to perpetuate the original location of this corner.

Replaced 4" tamarack post with 2 1/2" Bernitsen A-1 Federal Monument, aluminum with magnets installed in cap and base. Cap stamped.

Drove support stakes beside iron pipe.

Pipe projects 12" above ground.

NBTs - Tamarack 6" S 56° W 69.8 lks. Scribed SC BT. R 11 E 25 30 R
Tamarack 6" N 76° E 60.6 lks. Scribed SC BT. 36 31 12
Tamarack 6" S 90° W 98.0 lks. Scribed SC BT. 1976

Corner sets 1 chain east of former old grownup range line road.

Dated at Orineland, Wis. this 23rd day of March, 1976

Signature Phillip T. Hansen Title Registered Land Surveyor Registration No. S-498
(County Surveyor, Registered Land Surveyor, or other duly authorized official)

Office of Register of Deeds, County of Oneida
Instrument was filed in this office for record on the 5th day of April, 1976
at 1:30 o'clock P. M. I hereby certify that the within

Dora Terzagge Kuehn
(Register of Deeds)

By Dora Terzagge Kuehn Deputy

0000050000