


CERTIFIED LAND CORNER RESTORATION


Index No. **V-23**

State of Wisconsin } ss.
 County of Oneida

I Philip T. Hansen, do hereby certify that on the 2nd day of June, 1975, I found evidence of the Quarter corner of Sections 25 and 36 Township 36 North, Range 11 East, Fourth Principal Meridian, as described hereon; and that from this evidence I established a new monument and accessories as described hereon to perpetuate the original location of this corner.

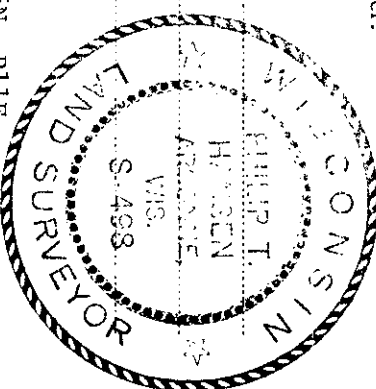

Resident witnesses:

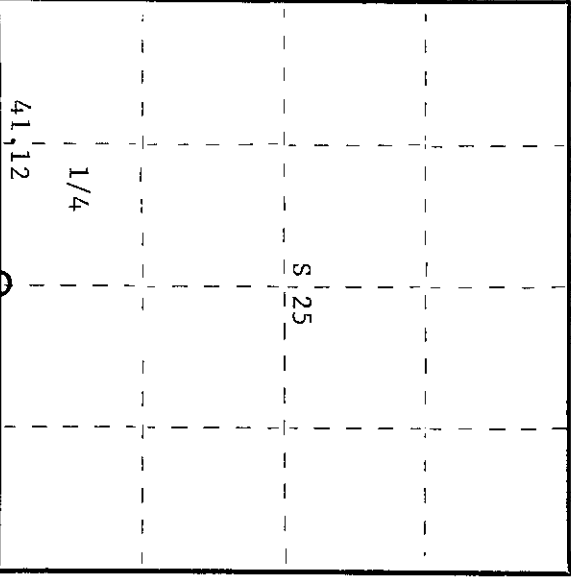

○ = Corner monument restored.

History of original corner establishment: Original corner established by Wm. E. Dougherty, Government Deputy Surveyor, in 1859 from which white pine 6" bears N14°E, 9 links and white pine 10" bears S59°W, 8 links.

Corner recovered and restored by B.F. Dorr, County Surveyor, in 1906 from which Norway pine stump 12" bears S15°W, 24-1/3 links and pine 10" bears N23°W, 15 links. Corner recovered in 1946 by H.C. Lawrence, Registered Land Surveyor. Set new post from recovered BT's which were burned but facing and notches were intact. He visited this corner again in 1954, found the pine post rotted off, dug out the point, and replaced it with a 4" tamarack post. The Norway stump still remained but the other pine was rotted entirely. No identifying marks remained. Only aspen trees available for BT's so none were set.

Description of corner evidence found:
 Recovered 4" tamarack post, squared and scribed 1/4S S25, 1/4S S35, in poor condition.

Recovered OBT's - White pine 10" N23°W 15.0 links now a decayed mound
 Norway stump 12" S15°W 24.5 links scribed BO; other old scribing just visible but not readable

Description of monument and accessories I established to perpetuate the original location of this corner.
 Replaced 4" cedar post with 2 1/2" iron pipe with brass cap stamped - S498

NBT's - Aspen 7" N26°E 47.7 links scribed 1/4 BT T36N, R11E
 Aspen 8" S25°E 7.0 links scribed 1/4 BT 1/4 S+25
 36

No other trees near suitable for BT's.

CPI-1975

Dated at Rhineland, Wis., this 22nd day of July, 1975.

Signature: *Philip T. Hansen* Title: Registered Land Surveyor Registration No. S-498
 County Surveyor, Registered Land Surveyor, or other duly authorized official

Office of Register of Deeds, County of Oneida
 Instrument was filed in this office for record on the 1st day of October, 1975 at 3:00 o'clock P.M.

Doris Verage Fisher
 (Register of Deeds)

By: Deputy