

CERTIFIED LAND CORNER RESTORATION



Index No. **S-23**

State of Wisconsin } ss.  
 County of Oneida

I Philip T. Hansen do hereby certify that on the 26th day of July 1976 I found evidence of the NC 1/16 corner of section 25 Township 36 North, Range 11 East, Fourth Principal Meridian,

as described hereon; and that from this evidence I established a new monument and accessories as described hereon to perpetuate the original location of this corner.

Resident witnesses:  
 Glen Barker  
 Jim Clafflin  
 Herb Magoner

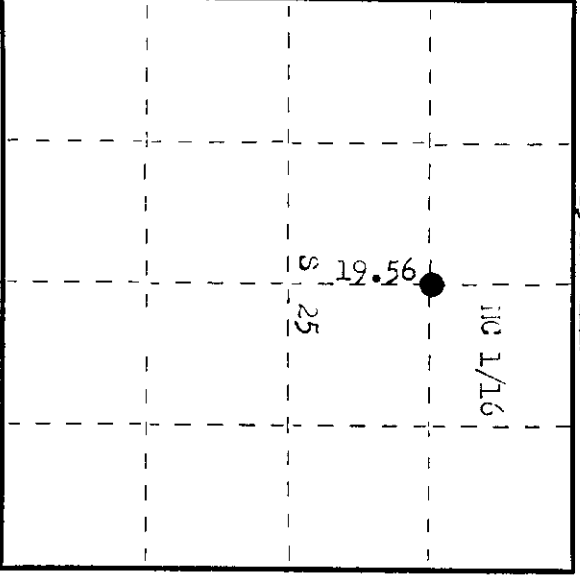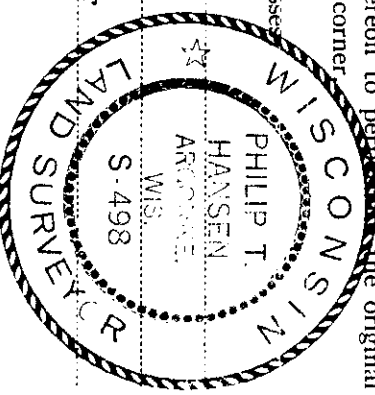

○ = Corner monument restored.

History of original corner establishment: Corner established by J. B. F. Dorr, County Surveyor, in 1899. Set post and marked BT - Tamarack 12" bears S 30° W 25 links. Corner recovered by H. C. Lawrence, Registered Land Surveyor, in 1954. Ran the random line north from Dorr's C 1/4 corner. Recovered Dorr's NC 1/16 corner at 19.56 chains north 9/4 links west. Corrected bearing N 1° 55' W. Dug out Dorr's point of old stake from the muck. Set new cedar post and marked BT's - Tamarack 8" S 30° W 29 links, and Tamarack 6" N 75° W 7 links.

Description of corner evidence found:

Recovered 5" cedar post, squared and scribed NC 1/16 S 25 NC 1/16 S 25 in fair condition. Also recovered Dorr's old point buried beside Lawrence's post.  
 Recovered BT's - Tamarack 12" S 30° W 35 links (now a 12" stub, laying down, scribed 1/8" BT still visible) (Dorr's).  
 Tamarack 8" (10") S 30° W 29 links, scribed NC 1/16 BT.  
 Tamarack 6" N 75° W 7 links, now a 5" stub, scribed S 25 BT.

Description of monument and accessories I established to perpetuate the original location of this corner.  
 replaced cedar post with 1 1/2" OD iron pipe with brass cap stamped.  
 monument projects 18" above ground. T36N R11E S 498  
 BT - Tamarack 7" N 66° W 13.4 links, scribed 1/16 BT. NC 1/16 S 25  
 monument and BT's painted blue. CFI-1976

Dated at Rhinelander, Wis., this 23rd day of August, 1976

Signature: *Philip T. Hansen* Title: Registered Land Surveyor Registration No. 3-498  
 County Surveyor, Registered Land Surveyor, or other duly authorized official

Office of Register of Deeds, County of Oneida. I hereby certify that the within instrument was filed in this office for record on the 23rd day of September, 1976 at 2:10 o'clock P. M.

*Lore Verager Kuehn*  
 (Register of Deeds)

By: Deputy

02030251136