

CERTIFIED LAND CORNER RESTORATION

Index No. 1-20

History of original corner establishment:
 B.F. Dorr, County Surveyor, ran this line in 1899 from section corner 25, 26, 35, 36 to section corner 26, 27, 34, 35. Set 1/4 corner at 41.77.
 No records of any E 1/16 corner having been set.

State of Wisconsin } ss.
 County of Oneida



I Phillip T. Hansen, do hereby certify that on the 17th day of April, 1978, I ~~found~~ re-established the E 1/16 corner of Sections 26 & 35

Township 36, North, Range 11 East, Fourth Principal Meridian,

as described hereon; and that from this evidence I established a new monument and accessories as described hereon to perpetuate the original location of this corner.

Resident witnesses:

- Glen Barker
- Jim Claflin
- Herb Wagoner

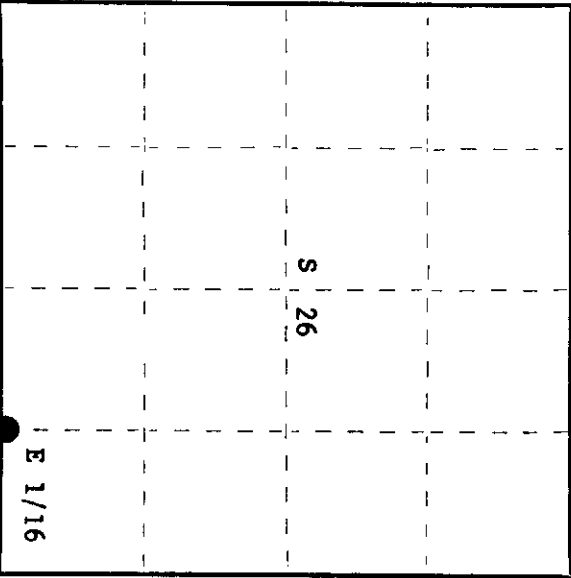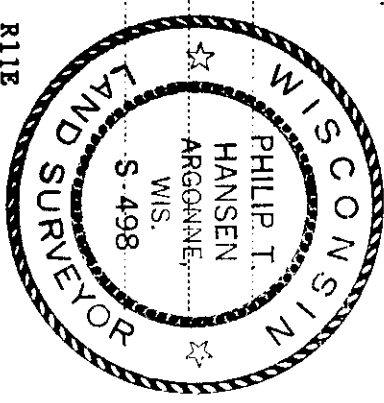

○ = Corner monument restored.

Description of corner evidence found:

Ran traverse from re-established section corner 25, 26, 35, 36 to re-established 1/4 corner between sections 26 & 35. Computed distance 2768.383 feet at corrected bearing S 87° 45' W. Set E 1/16 corner at 1384.192 ft. Intermediate.

Description of monument and accessories I established to perpetuate the original location of this corner.

- Set 1 1/2" iron pipe at 1384.92 ft. in Pergande Road 4" below surface of road.
- Set 1 1/2" iron pipe with 2" brass cap, projecting 18" above ground 40 feet north of true corner for a witness corner. Cap stamped:
- Marked NBT's - Aspen 6" S12°E 33.75 feet S498
- Maple 6" S52°E 55.3 feet, scribed 1/16 BT. T36N R11E
- E 1/16 S 26 1/35 W.C.C.
- S 40 ft.

Dated at Rhinelander, Wis., this 1st day of May, 1978.

Signature Phillip T. Hansen, Title Registered Land Surveyor, Registration No. S-498
 (County Surveyor, Registered Land Surveyor, or other duly authorized official)

Office of Register of Deeds, County of Oneida
 instrument was filed in this office for record on the 15th day of May, 1978
 at 2:00 o'clock P. M.

Dennis Verage Kuehn
 (Register of Deeds)

By Jack M. Boerner Deputy

3611260010