

U.S. PUBLIC LAND SURVEY MONUMENT RECORD

State of Wisconsin

County of: **ONEIDA** }

I, **DANIEL K. PLEOGER**, do hereby certify that on the 8th day of March, 2000

I found evidence of the 1/4 corner between sections 26 and 35

Township **36 North**, Range **11 East**, Fourth Principal Meridian, as described hereon;
and made new accessories as described hereon to perpetuate the original location of this corner:

Description of original monument and accessories and subsequent restorations:

The 1/4 corner between sections 26 and 35 was remonumented by Phil Hansen on April 17, 1978. See his certified Land Corner Restoration.

Hansen set a 1 1/2" x 18" iron pipe, 4" below the road surface. Set aluminum monument for a witness at 40 feet north.

White birch 8" S24W 54.3 feet (now a dead stub)

White birch 6" S10W 31.4 feet (now a dead stub)

White birch 7" S37E 84.8 feet (down)

White pine 6" S12E 81.2 feet (ok)


EVIDENCE FOUND AND JUSTIFICATION FOR LOCATING CORNER AS SHOWN:

I recovered a 1 1/4" iron pipe, 6" below the surface of Pergande road. Found Hansen's 2 1/2" aluminum witness monument at 40.00 feet north.

Found bearing trees as noted above. Distance's from bearing trees varied about 1 foot north and south from the found iron pipe.

I accepted the position of the found iron pipe.

I referenced the corner as shown on the drawing on the reverse side.

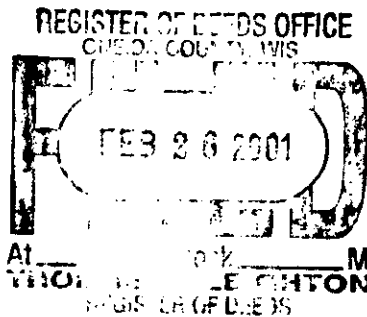

T36N R11E

	S 26		

Resident witnesses

Dated at Winter, Wisconsin, this 8th day of January, 2001.

Signature Daniel K. Pleoger Title **Registered Land Surveyor**

Surveyors Registration No. **1537**

Office of _____ County of _____

I hereby certify that the within instrument was filed in this office for record on the _____ day of _____ 19____, and was filed in Book No. _____

Page No. _____ of County Records.

Signature _____ Title _____

