

U.S. PUBLIC LAND SURVEY MONUMENT RECORD

State of Wisconsin

County of: **ONEIDA**}

I, **DANIEL K. PLEOGER**, do hereby certify that on the 12th day of July, 2000,

I established the NW 1/16 corner of section 26

Township **36 North**, Range **11 East**, Fourth Principal Meridian, as described hereon;

and made new accessories as described hereon to perpetuate the original location of this corner:



Description of original monument and accessories and subsequent restorations:

I established the NW 1/16 corner of section 26 by normal section subdivision.

Set a 1" x 42" iron pipe with aluminum cap, projecting 18" above ground. An old fence runs west at 17 feet north of the corner.

BTs: 8" sugar maple N5E 4.29 feet
 11" sugar maple S68W 42.50 feet
 7" sugar maple S48E 12.95feet

All blazed and scribed 1/16 BT, measured to 60d nail in BTs.

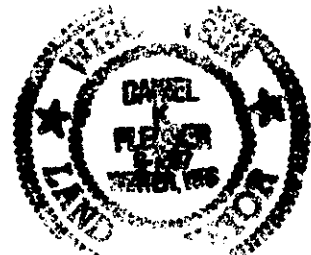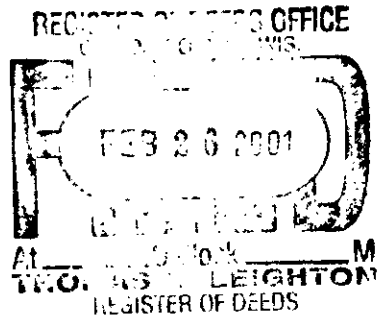

T36N R11E

⊕			
	S	26	

Resident witnesses

Dated at Winter, Wisconsin, this 13th day of February, 2001.

Signature *Daniel Pleoger* Title **Registered Land Surveyor**

Surveyors Registration No. **1537**

Office of _____ County of _____

I hereby certify that the within instrument was filed in this office for record on the _____ day of _____ 19 _____, and was filed in Book No. _____

Page No. _____ of County Records.

Signature _____ Title _____