


CERTIFIED LAND CORNER RESTORATION

Index No. Y-15


State of Wisconsin

County of Oneida } ss.

I Daniel K. Pleoeger do hereby certify that on the 17th day of November 19 81, I found the quarter corner of sections 27 & 34 Township 36 North, Range 11 East, Fourth Principal Meridian, as described hereon; and that from this evidence I established a new monument and accessories as described hereon to perpetuate the original location of this corner.

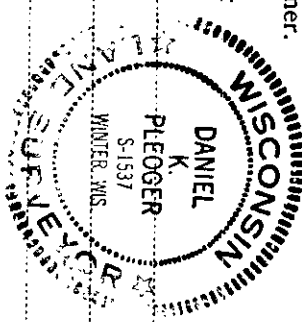

Resident witnesses:

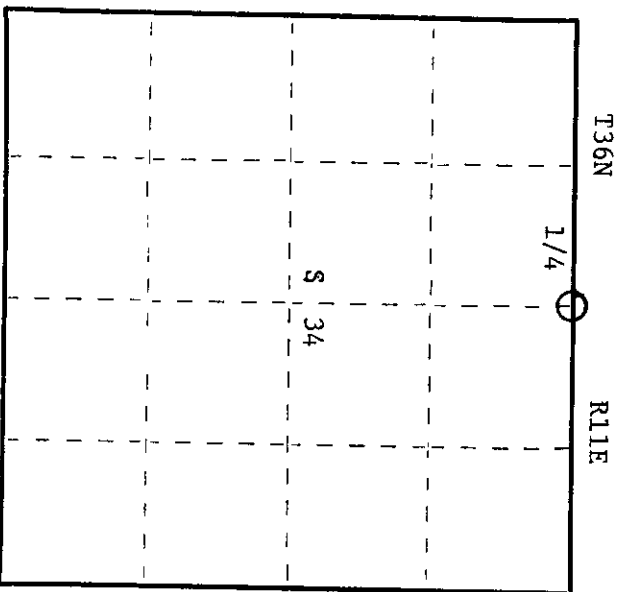

O = Corner monument restored.

History of original corner establishment:

Original corner established in 1859 by William E. Doherty, Gov. deputy surveyor. From which sugar 12" bears N41E 18 lks and Birch 16" bears S20W 46 lks.

Description of corner evidence found:

Re-established 1/4 corner by retracement distance of a recorded distance by Monsell and D.H. Vaughan, the latter in 1907. The above surveyor had a distance of 2847.90 ft. from C 1/4 which is in the centerline of old Hwy #8 to 1/4 corner between sections 27 & 34. The north-south 1/4 line being in the centerline of Slyzewski road. Located C 1/4 position and ran south in centerline of Slyzewski Road a distance of 2847.90 ft. and set 1/4 corner. Bud Slyzewski, a life-time resident and local land owner stated this position was accurate to his remembrance.

Description of monument and accessories I established to perpetuate the original location of this corner. Set a 1 1/2" x 18" iron pipe in centerline of Slyzewski Road for true corner 4" below road bed. Set a 2 1/2" aluminum pipe with alloy cap 32.70 ft. east of true corner for witness corner stamped:

- Marked NBTs to true corner:
White spruce 8" S40E 82.08 ft.
Red pine 12" S23E 102.00 ft.
Sugar 6" N77E 65.66 ft.
T36N R11E
S 27 W.C.
1/4 S 34
W 32.70 ft. to Cor
S1537 - 1981

Dated at Rhineland, Wis., this 8th day of January, 1982.

Signature: Daniel K. Pleoeger, Registered Land Surveyor, Title: County Surveyor, Registered Land Surveyor, of other duly authorized official, Registration No. 1537. Office of Register of Deeds, County of Oneida, 24th day of March, 1982. I hereby certify that the within instrument was filed in this office for record on the 11th day of March, 1982.

David George Kuehn, Register of Deeds

By: Deputy

3641270020