

CERTIFIED LAND CORNER RESTORATION

Index No. V-14

State of Wisconsin

County of Oneida } ss.

I Daniel K. Pleoeger, do hereby

certify that on the 11th day

of December, 19 81, ~~1981~~



Est. ~~of~~ the W 1/16 corner of Sections 27 & 34

Township 35, North, Range

11 East, Fourth Principal Meridian,

as described hereon; and that from this evidence I established a new monument and accessories as described hereon to perpetuate the original location of this corner.

Resident witnesses:

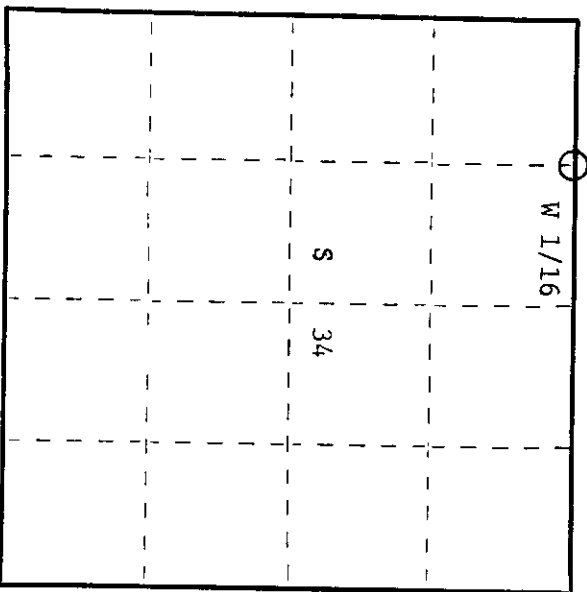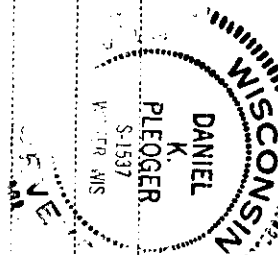

CERTIFIED LAND CORNER RESTORATION

History of original corner establishment:

H.C. Lawrence's post bears east 11.00 ft of new position. When Lawrence set this corner he did not have 1/4 corner between sections 27 & 34. Neither did he establish one.

Description of corner evidence found:

Total distance from section corner 27-28-33-34 to 1/4 corner between sections 27 & 34 is 3256.997 ft. at brg. S79-26-45E. Set W 1/16 1628.50 ft. intermediate.

Description of monument and accessories I established to perpetuate the original location of this corner. Set a 1 1/2" iron pipe with 2" diameter aluminum cap stamped:

Monument projects 18" above ground.

Marked NBTs:

- Hemlock 10" N88E 32.14 ft.
  - Hemlock 11" N79W 3.14 ft.
  - Hemlock 8" North 48.00 ft.
- Scribed 1/16 - B.T.

T36N R11E  
S 127  
S 34

CPI - 1981

Dated at Rhinelander, Wis., this 8th day of January, 1982

Signature Daniel K. Pleoeger Title Registered Land Surveyor Registration No. 1537  
(County Surveyor/Registered Land Surveyor, or other duly authorized official)

Office of Register of Deeds, County of Oneida, I hereby certify that the within instrument was filed in this office for record on the 34th day of March, 1982 at 10:35 o'clock A. M.

Donna Savage Fuchs  
(Register of Deeds)

By \_\_\_\_\_ Deputy

3611270030