


CERTIFIED LAND CORNER RESTORATION

Index No. **V-13**


State of Wisconsin } ss.
 County of Oneida

I, Philip T. Hansen, do hereby certify that on the 2nd day of July, 1975, I found evidence of the Section corner of S27, S28, S33, and S34 Township 36 North, Range 11 East, Fourth Principal Meridian, as described hereon; and that from this evidence I established a new monument and accessories as described hereon to perpetuate the original location of this corner.

Resident witnesses:

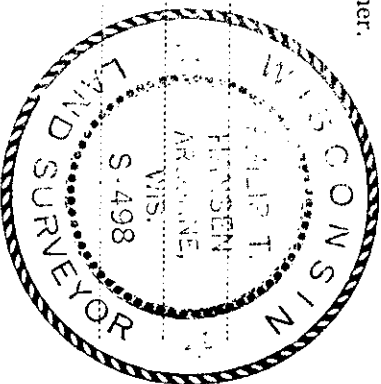

T36N, R11E

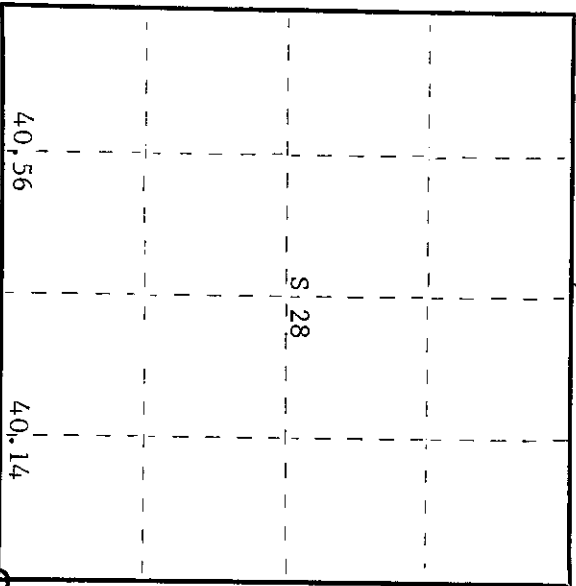

○ = Corner monument restored.

History of original corner establishment: Original corner established by Wm. E. Dougherty, Government Deputy Surveyor, in 1859 from which white birch 12" bears S65°W, 12 links and white birch 6" bears S47°E, 10 links.

D. H. Vaughan recovered this corner in 1901. Found marks on S.W. BT but tree was very rotten. Distance from S-1/4 corner 40.14 chains. He states that Monsell had set this corner by proportional measure but was 5 chains East of true corner. Made NBT's hemlock 12", N22 1/2°E, 15 links and birch 10", S38°W, 8 links.

Corner re-established by H. C. Lawrence, Registered Land Surveyor, in 1955. He did not recover this corner but set it at 40.14 chains East of N-S 1/4 line road, Sections 28 and 33, 49.00 chains West of N-S 1/4 line road, Section 27, 40.41 chains South of Highway 8 and 40.40 chains North of 1/4 corner between Sections 33 and 34. Set BT's sugar maple 9", S7°W, 32 links and sugar maple 11", N58°E, 41 links.

Description of corner evidence found:

Recovered 4" cedar post, squared and scribed S29; S28; S33; and S34, in poor condition. The post had rotted and broken off at the ground. Recovered old point in the ground.

Recovered OBT's - Sugar maple 9" (10") S7°W 32.5 links scribing grown over
 Sugar maple 11" (12") N58°W 41.0 links scribed S27 BT

Description of monument and accessories I established to perpetuate the original location of this corner.
 Replaced point of Lawrence's post with 2 1/2" iron pipe with brass cap stamped -

NBT - Sugar maple 7" S74°W 51 links scribed SC BT

S28 | S27
 S33 | S34

T36N, R11E

CPI-1975

Dated at Rhinelander, Wis. this 22nd day of July, 1975.
 Signature *Philip T. Hansen* Title, Registered Land Surveyor Registration No. S-498
 (County Surveyor, Registered Land Surveyor, or other duly authorized official)

Office of Register of Deeds, County of Oneida
 Instrument was filed in this office for record on the 1st day of October, 1975 at 3:00 o'clock P.M.
 I hereby certify that the within

Donna Savage Fisher
 (Register of Deeds)

By: Deputy

0000871193