

CERTIFIED LAND CORNER RESTORATION

Index No. V-12


State of Wisconsin

County of Oneida } ss.

I, Philip T. Hansen, do hereby certify that on the 2nd day of July, 1975, I found evidence of the E-1/16 corner of Sections 28 and 33 Township 36, North, Range 11 East, Fourth Principal Meridian,

as described hereon; and that from this evidence I established a new monument and accessories as described hereon to perpetuate the original location of this corner.

Resident witnesses:

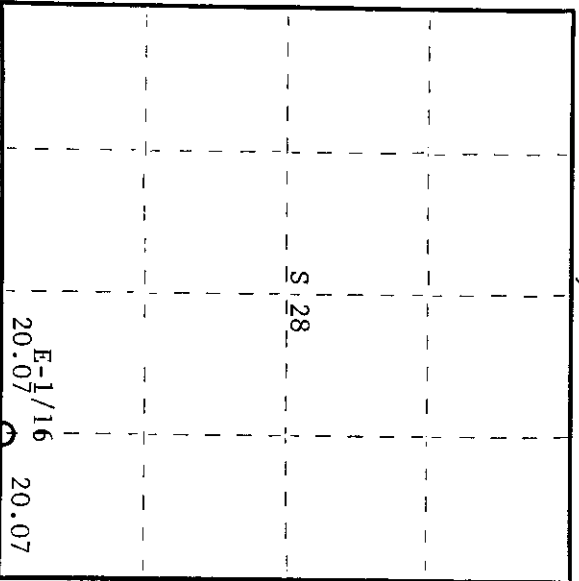

O = Corner monument restored.

History of original corner establishment:

Corner established by H.C. Lawrence, Registered Land Surveyor, in 1955 during his retracement and subdivision survey. This corner was set at 20.07 chains, equidistant between the 1/4 corner between Sections 28 and 33 and Section Corners 27, 28, 33, and 34. Set a 2" x 4" cedar post from which white birch 4" bears S25°E, 12 links and aspen 9" bears N35°W, 27 links.

Description of corner evidence found:

Recovered 2" x 4" cedar post, squared and scribed S28 E-1/16, S33 E-1/16, in very poor condition.

Recovered ORT's - Aspen 9" N35°W 27 links now a cut off decayed stump  
White birch 4" (6") S25°E 12 links top scribing grown over BT

Description of monument and accessories I established to perpetuate the original location of this corner.  
Replaced point of 2" x 4" wooden stake with 1 1/2" OD iron pipe with 2" brass cap stamped -

S498  
T36N, R11E

NBT - White birch 5" N14°W 37.8 links scribed 1/16 BT

E-1/16 S|28  
S|33

CPI-1975

Dated at Rhineland, Wis., this 22nd day of July, 1975.

Signature Philip T. Hansen Title Registered Land Surveyor Registration No. S-498  
(County Surveyor, Registered Land Surveyor, or other duly authorized official)

Office of Register of Deeds, County of Oneida  
Instrument was filed in this office for record on the 1st day of October at 3:00 o'clock P. M. I hereby certify that the within

Dorcas Virginia Kuehn  
(Register of Deeds)

By \_\_\_\_\_ Deputy

361280010