

CERTIFIED LAND CORNER RESTORATION


Index No. V-8

State of Wisconsin } ss.
County of Oneida


I Phillip T. Hansen, do hereby certify that on the 4th day of December, 1979, I found evidence of the E 1/16 corner of Sections 29 and 32 Township 36, North, Range 11 East, Fourth Principal Meridian, as described hereon; and that from this evidence I established a new monument and accessories as described hereon to perpetuate the original location of this corner.

Resident witnesses:

- Glen Barker
- Jim Claflin
- Herb Wagoner

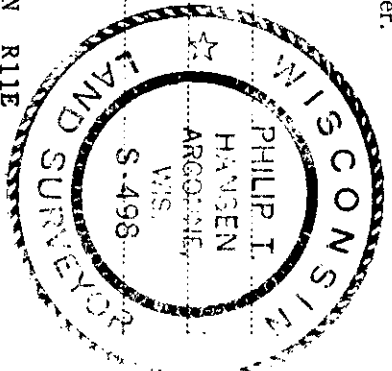

T36N R11E

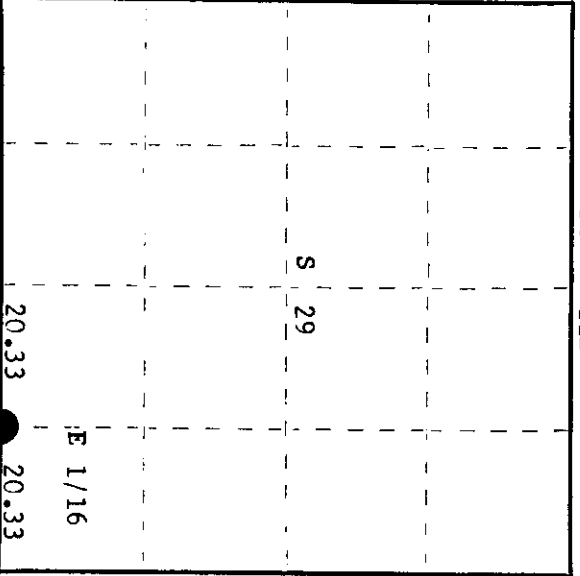

○ = Corner monument restored.

History of original corner establishment:

No records of any original survey. Corner established by H.C. Lawrence, Registered Land Surveyor, in 1955. Ran a random line from recovered section corner 28, 29, 32 and 33 S 86° 30' W a distance of 81.32 chains to close out 32 links north of section corner 29, 30, 31 and 32. Established 1/4 corner at 40.66 chains intermediate and set E 1/16 corner at 20.33 chains intermediate. Set 5" cedar post and marked NBT's - Yellow Birch 12" S 5° W 54 links; Elm 7" N8°E 73 links.

Description of corner evidence found:

Recovered 5" cedar post, squared and scribed E 1/16 S29, E 1/16 S32, standing in fair condition.
 Recovered OBT's - Yellow Birch 12" S5°W 54 links (55.1 links), now dead, scribed E 1/16 S32. Elm 7" (10") N8°E 73 links, scribing grown over.

Description of monument and accessories I established to perpetuate the original location of this corner.

Replaced cedar post with 1-1/2" iron pipe with 2" brass cap, stamped:
 Monument projects 24" above ground. S498
 Marked NBT's - Maple 5" S89°E 41.5 links T36N R11E
 Sugar 5" N6°W 23.5 links E 1/16 S+29
 scribed 1/16 BT's. CPI-1979

Dated at Rhinelander, Wis., this 26th day of December, 1979.

Signature Phillip T. Hansen Title Registered Land Surveyor Registration No. S-498
County Surveyor, Registered Land Surveyor, or other duly authorized official

Office of Register of Deeds, County of Oneida, I hereby certify that the within instrument was filed in this office for record on the 14th day of January, 1980 at 1:30 o'clock P.M.

Donna Leage Fuchs
Register of Deeds

By: _____ Deputy

36112900-0