

CERTIFIED LAND CORNER RESTORATION



Index No. **V-4**

State of Wisconsin



Resident witnesses:

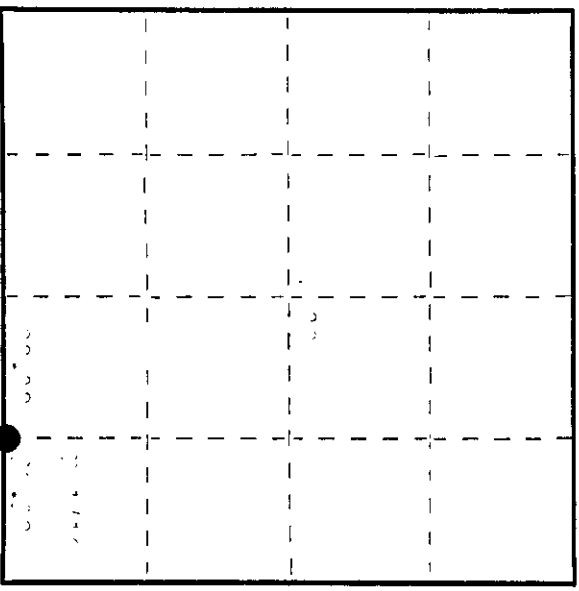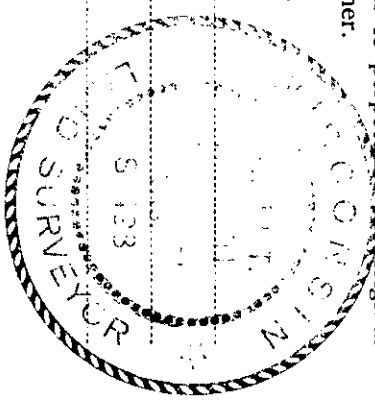

○ = Corner monument restored.

History of original corner establishment:

*[Faint, mostly illegible text describing the history of the original corner establishment.]*

Description of corner evidence found:

*[Faint, mostly illegible text describing the corner evidence found.]*

Description of monument and accessories I established to perpetuate the original location of this corner.

*[Faint, mostly illegible text describing the monument and accessories.]*


Signature John J. ... Title Surveyor Registration No. ...  
(County Surveyor, Registered Land Surveyor, or other duly authorized official)


(Register of Deeds)

By ... Deputy