

CERTIFIED LAND CORNER RESTORATION

Index No. A-9

State of Wisconsin }
County of Oneida } ss.

I, Philip T. Hansen, do hereby certify that on the 4th day of November, 1976, I found evidence of the Section Corner corner of Sec. 32, 33, 4 & 5 Township 35-36, North, Range 11 East, Fourth Principal Meridian, as described hereon; and that from this evidence I established a new monument and accessories as described hereon to perpetuate the original location of this corner.

Resident witnesses:


Glen Barker

Jim Claflin

Herb Wagoner



FORM 985 Wisconsin Planning Authority

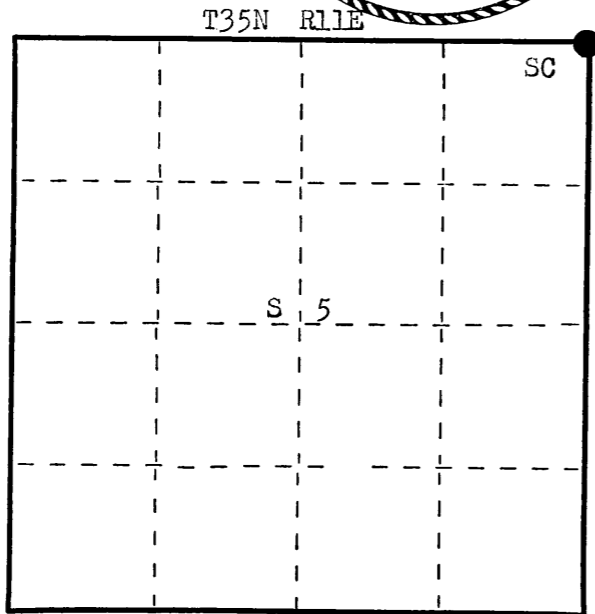

○ = Corner monument restored.

History of original corner establishment: Original Corner established by Hiram C. Fellows, Deputy Surveyor, in 1859 from which Tamarack 10" bears N 19° E 55 links, Tamarack 10" bears N 57° W 36 links, Tamarack 6" bears S 52° W 12 links, Tamarack 10" bears S 8° E 88 links. B.F. Dorr, County Surveyor, claims to have recovered this corner in 1898. D.H. Vaughan, County Surveyor, used this corner and claims to have found the original trees. V.M. Maine, County Surveyor, set 2½" iron pipe when he ran the line between Sec. 4 and 5. H.C. Lawrence, Registered Land Surveyor, recovered the corner in 1953. Set a 3" cedar post and marked NBT - Black Spruce 6" N 16° E 52.2 links, scribed S4, BT.

Description of corner evidence found:

Recovered an old 18" cedar point (Vaughan's or Dorr's), Maine's 2½" iron pipe with brass cap, also H.C. Lawrence's 3" cedar post, squared and scribed S4, S5, S32, S33. This sets 1.5 links east of old point. Maine's I.P. is .5 link north of old wood point.

Recovered OBTs - Black Spruce 6" N 67° W 9.1 links, scribed S32 BT.
Black Spruce 6" N 16° E 52.2 links, scribed S4 BT.

Description of monument and accessories I established to perpetuate the original location of this corner.

As Maine's iron pipe was in perfect condition, it was moved .5 link south to hole of old wood point. Drove old wood point beside iron pipe.

Monument projects 2½' above ground. Cap stamped:
NBTs - Black Spruce 7" N 28° E 64.7 links, scribed SC BT.
Black Spruce 6" S 49° W 12 links, scribed SC BT.

T36N R11E
32 | 33
5 | 4
T35N R11E

Dated at Rhineland, Wis., this 30th day of November, 1976

Signature Philip T. Hansen Title Registered Land Surveyor Registration No. S-498
(County Surveyor, Registered Land Surveyor, or other duly authorized official)

Office of Register of Deeds, County of Oneida. I hereby certify that the within instrument was filed in this office for record on the 9th day of December, 1976 at 2:00 o'clock P M.

Doris Verage Kuehn
(Register of Deeds)

By Joseph M. Boomer Deputy

3611320000