

CERTIFIED LAND CORNER RESTORATION

Index No. **A-8**

State of Wisconsin

County of Walworth } ss.



I, Philip P. Applegate, do hereby certify that on the 11 day of November, 1970, I found evidence of the 1 1/4 corner of the Section 6 and 25 Township 25, North, Range 11, East, Fourth Principal Meridian, as described hereon; and that from this evidence I established a new monument and accessories as described hereon to perpetuate the original location of this corner.

Resident witnesses:

Name and Address

Name and Address

Name and Address

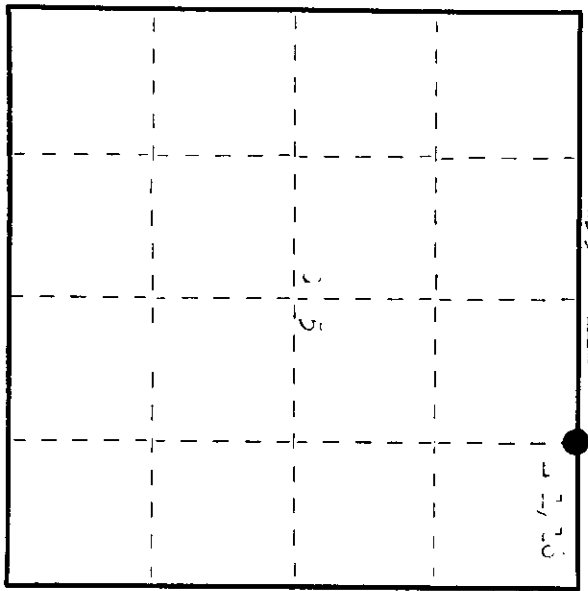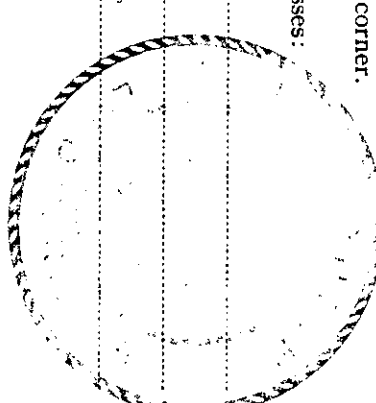

O = Corner monument restored.

History of original corner establishment:





Date: 11/10/70
By: P. Applegate
01-1-1970

Dated at Walworth, Wis., this 30th day of November, 1970.

Signature Philip P. Applegate Title County Surveyor (County Surveyor, Registered Land Surveyor, or other duly authorized official) Registration No. 27470

Office of Register of Deeds, County of Walworth I hereby certify that the within instrument was filed in this office for record on the 9th day of December, 1976 at 2:00 o'clock P. M.

By Carol George Theisen (Register of Deeds)
Joseph M. Bernier Deputy

3611320010