



State of Wisconsin }
County of Oneida } ss.

I Philip T. Hansen, do hereby certify that on the 3rd day of July, 1975, I found evidence of the Section corner of S33-S34-S3-S4 Township 36 and 35 North, Range 11 East, Fourth Principal Meridian, as described hereon; and that from this evidence I established a new monument and accessories as described hereon to perpetuate the original location of this corner.

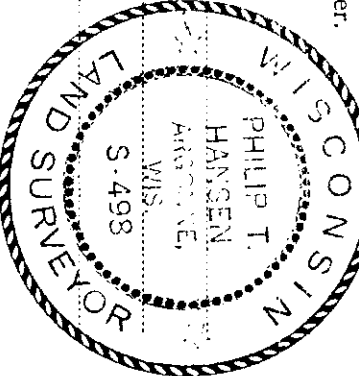

Resident witnesses:

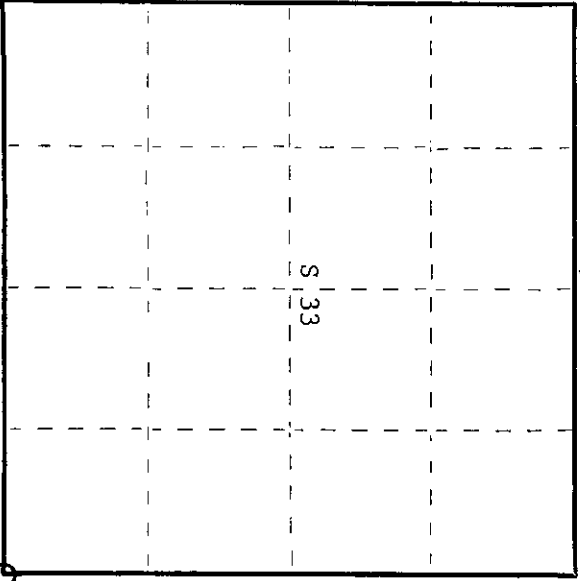

○ = Corner monument restored.

3611330000

History of original corner establishment: Original corner established by Hiram C. Fellows, Government Deputy Surveyor, in 1859 from which sugar maple 10" bears N32°W, 13 links; lind 12" bears N55°E, 6 links; sugar maple 9" bears S40°E, 24 links; and lind 10" bears S22°W, 31 links.

Corner recovered by H.C. Lawrence, Registered Land Surveyor, in 1953. He recovered the original sugar maple stump N32°W, 13 links. No marks visible. Sugar maple 16" marked years ago bears N71½°E, 28 links. He chopped out two sets of scribes; the oldest when tree was 9" in diameter. Recovered an iron pipe set near point of old wood post, broken off below the surface of ground. Set 5" cedar post and made NBT twin oaks 12", S22½°W, 43½ links.

Description of corner evidence found:
Recovered 2½" iron pipe with brass cap stamped - T36N, R11E
A 5" cedar post, squared and scribed S33 T36N, S4 S3, T35N, S34 R11E, 1
in good condition set next to the iron pipe. 9 S33/S34
Original OBT's sugar maple, N32°W, 13 links, decayed badly; sugar 4 S 4/S 3
maple 16", N71½°E, 28 links, now cut-off stump, BT visible; and 0
twin oaks 12", S22½°W, 43.5 links, now cut-off stump. T35N, R11E

Description of monument and accessories I established to perpetuate the original location of this corner. As iron pipe was in good condition, it was painted and left as is.

- NBT's - White birch 6" N32°W 20.4 links scribed SC BT
- White ash 6" S83°E 41.2 links scribed SC BT
- White birch 10" N31°E 48.4 links scribed SC BT

Dated at Rhinelander Wis., this 3rd day of July, 1975.

Signature: *Philip T. Hansen* Title: Registered Land Surveyor Association No. S-498
County Surveyor, Registered Land Surveyor, or other duly authorized official
Office of Register of Deeds, County of Oneida
Instrument was filed in this office for record on the 1st day of October, 1975
at 3:00 o'clock P.M.

Doris George Fisher
(Register of Deeds)

By: Deputy