



CERTIFIED LAND CORNER RESTORATION

Index No. **Z-12**

State of Wisconsin } ss.  
 County of Oneida }

I Philip T. Hansen do hereby certify that on the 2nd day of June, 1975, I found evidence of the E-1/16 corner of Sections 33 and 4 Township 36 and 35 North, Range 11 East, Fourth Principal Meridian, as described hereon; and that from this evidence I established a new monument and accessories as described hereon to perpetuate the original location of this corner.

Resident witnesses:

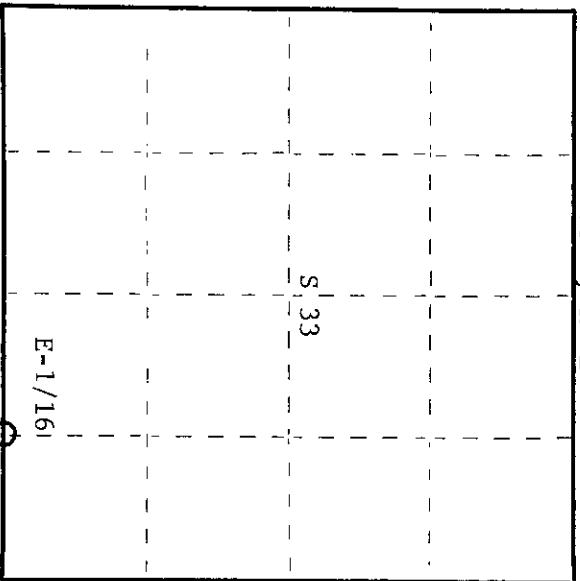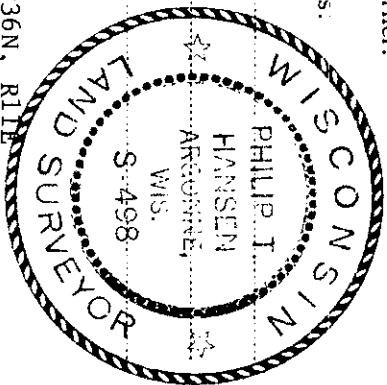

○ = Corner monument restored.

History of original corner establishment: Original corner established by D.H. Vaughan, County Surveyor, in 1906. He ran the South line, Section 33, from the S.E. corner set by B.F. Dorr, who found the original BT's, which now are all gone, to the S.W. corner. He set the E-1/8 corner from which hemlock 9" bears N42°E, 16 links and birch 16" bears S19½°E, 25½ links. H.C. Lawrence, Registered Land Surveyor, recovered Vaughan's hemlock BT stump in 1953 during his retracement survey. He set a new 4" cedar post at fence corner from which cedar stump 18" bears N39°E, 70½ links and hemlock 10" bears N39°E, 73½ links.

Description of corner evidence found:  
 Recovered Lawrence's 4" cedar post, squared and scribed E-1/16 S33, T36N; E-1/16 S4, T35N; in fair condition. This corner sets at the corner of a North and West fence line.

Recovered OBT's - Hemlock stump N33°E 16.0 links (Vaughan's) now decayed - scribing not visible  
 Cedar stump 18" N39°E 70.5 links scribed NBT E-1/16  
 Hemlock 10" (12") N39°E 73.5 links scribed S33

Description of monument and accessories I established to perpetuate the original location of this corner.  
 Replaced 4" cedar post with 1½" OD iron pipe with 2" brass cap stamped - S498  
 NBT - Hemlock 12" S6°E 38.6 links scribed 1/16 BT T36N, R11E

E-1/16 S|33  
 S|4

T35N, R11E  
 CPI-1975

Dated at Rhinelander, Wis., this 22nd day of July, 1975.

Signature *Philip T. Hansen* Title Registered Land Surveyor Registration No. S-498  
 (County Surveyor, Registered Land Surveyor, or other duly authorized official)

Office of Register of Deeds, County of Oneida  
 Instrument was filed in this office for record on the 1st day of October, 1975  
 at 3:00 o'clock P.M.

*Doris Terape Kuhn*  
 (Register of Deeds)

By: Deputy

3611330010