



CERTIFIED LAND CORNER RESTORATION

Index No. W-13

State of Wisconsin }
 County of Oneida } ss.

I Philip T. Hansen do hereby certify that on the 10th day of July, 1975, I found evidence of the N-1/16 corner of Sections 33 and 34 Township 36, North, Range 11, East, Fourth Principal Meridian, as described hereon; and that from this evidence I established a new monument and accessories as described hereon to perpetuate the original location of this corner.

Resident witnesses.

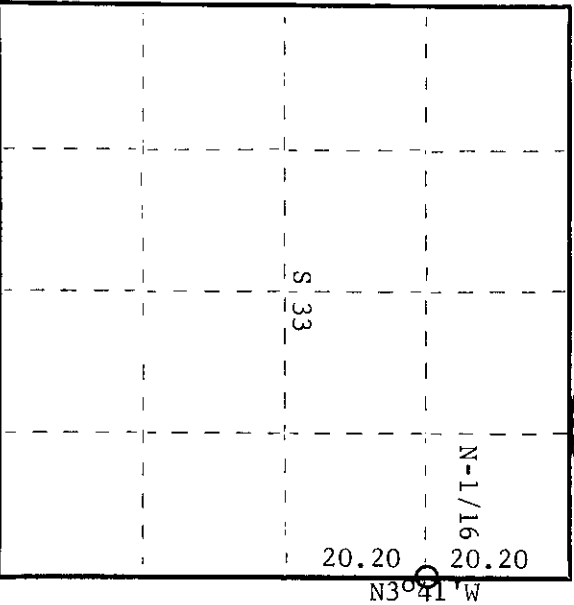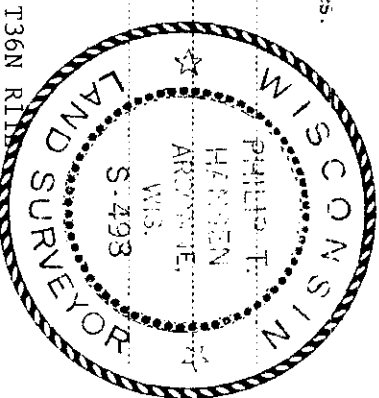

○ = Corner monument restored.

History of original corner establishment:

Corner established by H.C. Lawrence, Registered Land Surveyor, in 1953, during his retracement survey. From recovered 1/4 corner, he ran N3°30'W a distance of 40.40 chains, to a point 13 links east of section corner. Corrected bearing of line N3°41'W. Set 3" cedar post at N-1/16 corner 6 1/2 links west of 20.20 chains, intermediate from which tamarack 9" bears S52°W 21 links, and tamarack 6" bears S38°E 58 links.

Description of corner evidence found:

Recovered 3" cedar post, squared and scribed N-1/16 S33, N-1/16 S34, in fair condition.
 Recovered ORT's - tamarack 9" (10") S52°W 21 links Scribing grown over.
 Tamarack 6" (7") S38°E 58 links Scribed S34 RT.

Description of monument and accessories I established to perpetuate the original location of this corner.

Replaced 3" cedar post with 1 1/2" O.D. iron pipe with 2" brass cap stamped -
 No additional accessories.

T36N R11E
 S33 | S34
 N-1/16
 CPT-1975

S498

Dated at Rhinelanders, Wis., this 24th day of July, 1975.

Signature Philip T. Hansen Title Registered Land Surveyor Registration No. S-498
 (County Surveyor, Registered Land Surveyor, or other duly authorized official)

Office of Register of Deeds, County of Oneida
 Instrument was filed in this office for record on the 1st day of October, 1975
 at 3:00 o'clock P.M.

Doris Savage Fuchs
 (Register of Deeds)

By: _____ Deputy

3611333000