



CERTIFIED LAND CORNER RESTORATION

Index No. **2-17**

State of Wisconsin } ss.
 County of Oneida

I Philip T. Hansen, do hereby certify that on the 7th day of July, 19 75, I found evidence of the Section corner of 34-35-3-2 Township 36-35 North, Range 11, East, Fourth Principal Meridian, as described hereon; and that from this evidence I established a new monument and accessories as described hereon to perpetuate the original location of this corner.

Resident witnesses:

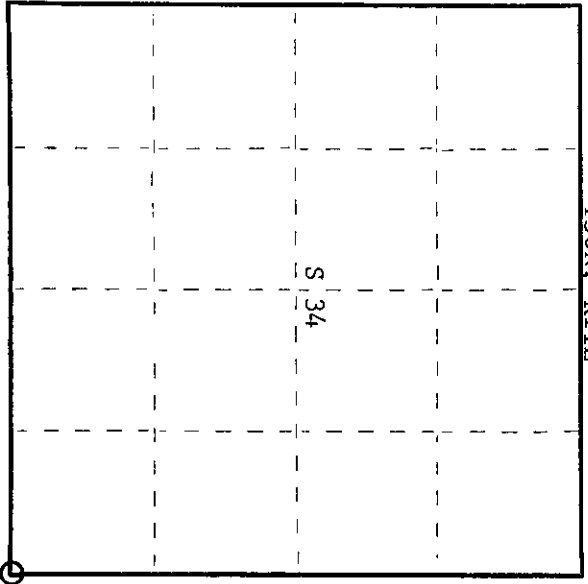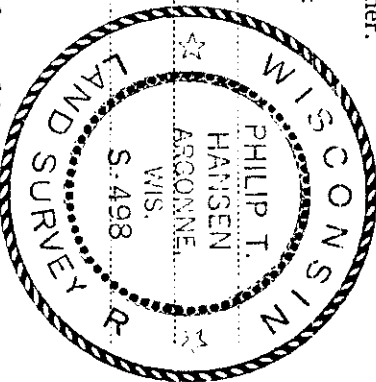

○ = Corner monument restored.

CERTIFIED LAND CORNER RESTORATION

History of original corner establishment:
 Original corner established by Hiram C. Fellows, Government Deputy Surveyor, in 1859 from which tamarack 10" bears N37°E, 4 links and tamarack 10" bears S62°W, 5 links. H.C. Lawrence, Registered Land Surveyor, states he found two old cedar posts, one very old and rotted. Neither post was ever scribed and he could not find any bearing trees or stumps but as the location checked to within 6 links for distances from 1/4 corners East and West he accepted the position. Set a new 6" cedar post in old posthole from which he made BT's cedar 7", N51½°W, 19 links and twin maples 6" and 3", S2°W, 13½ links.

Description of corner evidence found:
 Recovered 5" cedar post, squared and scribed S2; S35; S34; and S3, in fair condition. Also, a 3" x 3" cedar post wired to Lawrence's post.

Recovered OBT's - Cedar 7" (9") N51½°W (N48°W) 19.0 links scribed S34 NBT
 Red maple 6" (9") S2°W 13.5 links scribed S3 BT

Description of monument and accessories I established to perpetuate the original location of this corner.
 Replaced 5" cedar post with 2½" iron pipe with brass cap stamped -

No additional accessories.

S498
 T36N, R11E
 S34 | S35
 S 31 | S 2
 T35N, R11E
 CPT-1975

Dated at Rhineland, Wis., this 24th day of July, 19 75.

Signature *Philip T. Hansen* Title Registered Land Surveyor Registration No. S-498
 (County Surveyor, Registered Land Surveyor, or other duly authorized official)

Office of Register of Deeds, County of Oneida
 Instrument was filed in this office for record on the 1st day of October, 19 75
 at 3:00 o'clock P.M.

Daniel George Kuehn
 (Register of Deeds)

By _____ Deputy

3611340000