


CERTIFIED LAND CORNER RESTORATION

Index No. **Z-16**

State of Wisconsin }  
 County of Oneida } ss.

I Philip T. Hansen, do hereby certify that on the 8th day of July 19 75, I found evidence of the E-1/16 corner of Sections 3 and 34 Township 35 and 36 North, Range 11 East, Fourth Principal Meridian, as described hereon; and that from this evidence I established a new monument and accessories as described hereon to perpetuate the original location of this corner.

Resident witnesses:

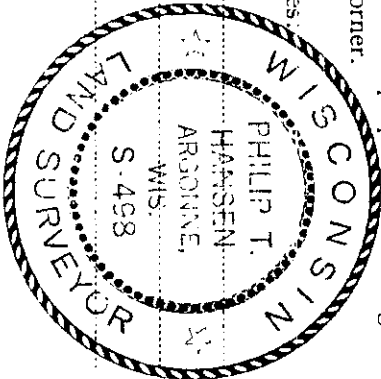

History of original corner establishment:  
 Corner established by H.C. Lawrence, Registered Land Surveyor, during his retracement survey in 1954.  
 From restored 1/4 corner (original) he ran N88°00'E, a distance of 40.26 chains, to intersect East line at 98 links North of section corner.  
 Set a 4" cedar post at 49 links South at 20.13 chains intermediate. Made NBT's basswood 16", S33°E, 14 links and white ash 9", N82°W, 35 links.

Description of corner evidence found:  
 Recovered 4" cedar post, squared and scribed E-1/16 S3, E-1/16 S34, in fair condition.  
 Recovered OBT's - Basswood 16" (18") S33°E 14 links (15.5 links)  
 scribbing grown over  
 White ash 9" (10") N82°W (N80°W) 35 links scribed S34 BT


Description of monument and accessories I established to perpetuate the original location of this corner.  
 Replaced 4" cedar post with 1-1/2" iron pipe with brass cap stamped -

No new bearing trees.

E-1/16 S 1/3  
 S 1/34

T35N, R11E  
 CPT-1975

T36N, R11E

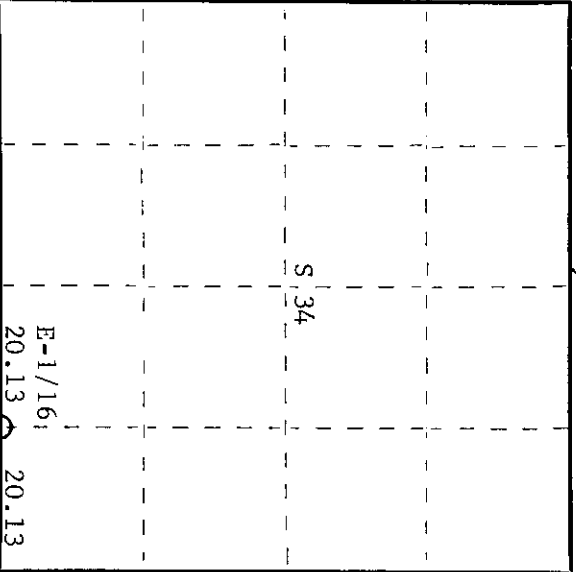

○ = Corner monument restored.

Dated at Rhinelander, Wis., this 24th day of July, 19 75.

Signature *Philip T. Hansen* Title Registered Land Surveyor Registration No. S-498  
 (County Surveyor, Registered Land Surveyor, or other duly authorized official)

Office of Register of Deeds, County of Oneida  
 Instrument was filed in this office for record on the 1st day of October, 19 75  
 at 3:00 o'clock P.M.

*Doris Lange Kuehn*  
 (Register of Deeds)

By: Deputy

3611340010