

CERTIFIED LAND CORNER RESTORATION


Index No. Y-14

State of Wisconsin }
County of Oneida } ss.

History of original corner establishment:
No evidence of any previous corner

I, Daniel K. Plegger, do hereby certify that on the 20th day of November, 1981, I found ~~the~~ corner of the SW 1/16 Section 34, Township 36 North, Range 11 East, Fourth Principal Meridian, as described hereon; and that from this evidence I established a new monument and accessories as described hereon to perpetuate the original location of this corner.

Resident witnesses:

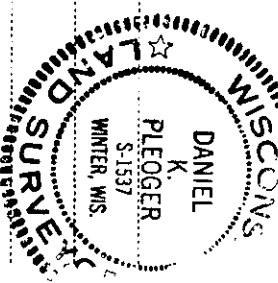


Description of corner evidence found:
Established SW 1/16 by subdivision of the SW 1/4. Location of SW 1/16 is \$2-17-30W 1236.41 ft. of WC 1/16 and N85-00-53W 1404.53 ft. of SC 1/16.

Description of monument and accessories I established to perpetuate the original location of this corner.
Set a 1 1/2" iron pipe with 2" diameter aluminum cap stamped:

Monument projects 12" above ground. S1537 T36N R11E

Marked NBTs:
Sugar 8" S59E 7.65 ft. SW 1/16 S 34
Sugar 6" N16W 32.94 ft. T36N R11E
Scribed 1/16 - B.T. CPI - 1981

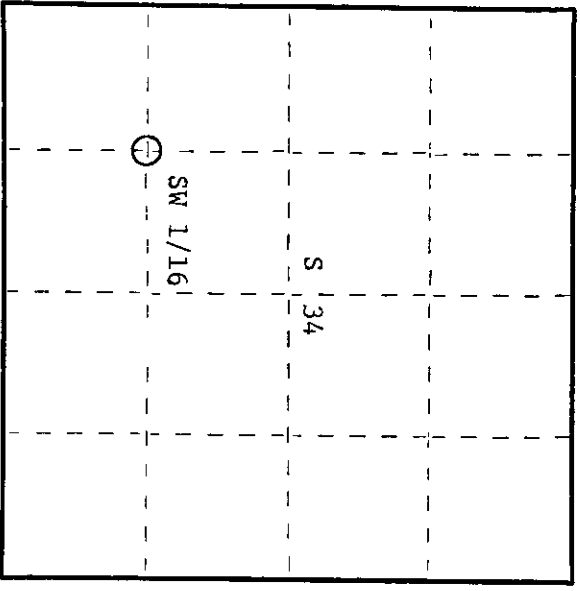

○ = Corner monument restored.

Dated at Rhineland, Wis., this 8th day of January, 1982.

Signature: Daniel K. Plegger, Registered Land Surveyor, Title: Registered Land Surveyor, Registration No. 1537
(County Surveyor, Registered Land Surveyor, or other duly authorized official)

Office of Register of Deeds, County of Oneida, at 10:35 o'clock on the 24th day of March, 1982. I hereby certify that the within instrument was filed in this office for record on the 24th day of March, 1982.

Deena Lange Tuelke
(Register of Deeds)

By: Deputy

3611341030