

CERTIFIED LAND CORNER RESTORATION

Index No. **A-20**



State of Wisconsin } ss.
 County of Oneida }

I Phillip T. Hansen, do hereby certify that on the 23rd day of June, 1976, I found evidence of the E 1/16 corner of Section 35 and 2 Township 35-36, North, Range 11 East, Fourth Principal Meridian, as described hereon; and that from this evidence I established a new monument and accessories as described hereon to perpetuate the original location of this corner.

Resident witnesses:

Jim Clarlin

Herb McGonner

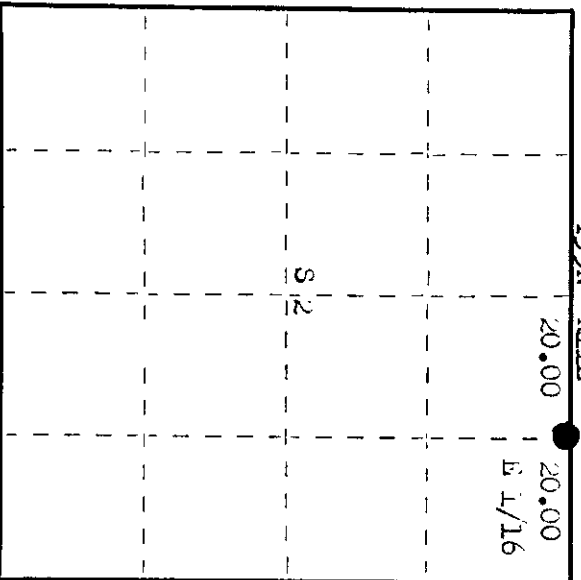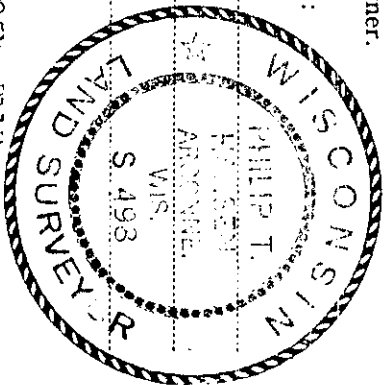

○ = Corner monument restored.

History of original corner establishment: Corner established by H.C. Lawrence, registered Land Surveyor, in 1954.
 Ran random line S 89° 30' E from recovered and restored original 1/4 Corner at 40.00 chains, Section Corner was 8 lks South.
 Set E 1/16 Corner North 4 lks at 20.00 chains equidistant, a 4" cedar post.
 No BTs were set.

Description of corner evidence found:
 recovered 0" squared cedar post, squared and scribed E 1/16 35, E 1/16 32, in poor condition.
 No BTs were recovered.

Description of monument and accessories I established to perpetuate the original location of this corner.
 replaced cedar post with 1 1/2" iron pipe with 2" brass cap stamped.
 monument projects 20" above ground.

BTs - Black Spruce 8" N 60° W 41.7 lks, scribed 1/16 BT. E 1/16 S 1/2
 Black Spruce 6" S 30° " 36.9 lks, scribed 1/16 BT. T36N R11E
 T35N R11E
 GPI-1976

Dated at Hainelander, Wis., this 12th day of August, 1976

Signature: *Phillip T. Hansen* Title: Registered Land Surveyor Registration No. S-498
 (County Surveyor, Registered Land Surveyor, or other duly authorized official)

Office of Register of Deeds, County of Oneida, I hereby certify that the within instrument was filed in this office for record on the 23rd day of September, 1976, at 1:00 o'clock P.M.

Doni Verage, Fischer
 (Register of Deeds)

By: Deputy

3611350010