

CERTIFIED LAND CORNER RESTORATION



Index No. **2-19**

State of Wisconsin } ss.
 County of Oneida

I Phillip T. Hansen do hereby certify that on the 23rd day of June, 1976, I found evidence of the Quarter corner of Section 35 and 2 Township 36 and 35 North, Range 11 East, Fourth Principal Meridian, as described hereon; and that from this evidence I established a new monument and accessories as described hereon to perpetuate the original location of this corner.

Resident witnesses:

Jim Clarlin
 Herb Weagoner

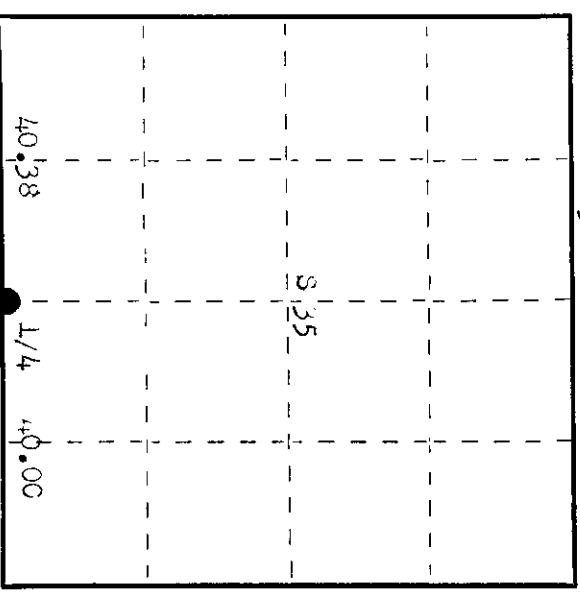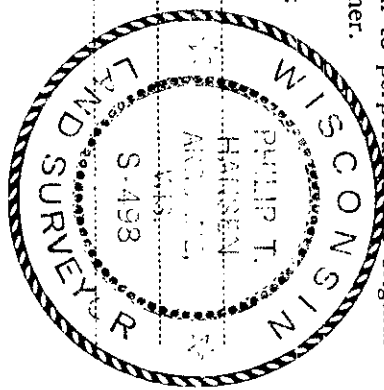

○ = Corner monument restored.

History of original corner establishment: Original Corner established by Hiram C. Fellows, Deputy Surveyor, in 1859, from which Tamarack 10" bears N 37° E 4 lks and Tamarack 10" bears S 62° W 5 lks.
 Corner recovered by H.C. Lawrence, Registered Land Surveyor, in 1954. Found low stump of original Tamarack S 62° W 5 lks and rotted stump of other original BT N 37° E 4 lks.
 Dug up point of original post.
 Set new 4" cedar post in old post hole. No acceptable trees for IETs.

Description of corner evidence found:
 Recovered 5" squared and scribed Cedar post, in fair condition.
 Recovered 1/4" scribed 5/8" BT. Also found the remains of old squared cedar post, fire scarred. Found an old cedar stump with axe marks, S 60° W 2.0 lks.

Description of monument and accessories I established to perpetuate the original location of this corner:
 Replaced cedar post with 2 1/2" Berntsen #1 Federal monument stamped.

- Monument projects 2 1/2" above ground.
 - 1. B.Spruce 5" N 32° E 32.0 lks, scribed 1/4 BT.
 - 2. B.Spruce 5" N 39° W 3.0 lks, scribed 1/4 BT.
 - 3. Spruce 5" S 12° W 49.6 lks, scribed 1/4 BT.
- Monument and BTs painted blue.

T3498
 T36N R11E
 S 35
 312
 T35N R11E
 CPT-1976

Dated at Raineland, Wis., this 12th day of August, 1976

Signature: *Phillip T. Hansen* Title: Registered Land Surveyor Registration No. S-498
 (County Surveyor, Registered Land Surveyor, or other duly authorized official)
 Office of Register of Deeds, County of Oneida
 Instrument was filed in this office for record on the 30th day of September, 1976
 at 10:00 o'clock P.M.

Donna Helene Fritsch
 (Register of Deeds)

By: Deputy

3611350020