

State of Wisconsin

County of Oneida } ss.

I Phillip T. Hansen do hereby certify that on the 19th day of April 19 78 I have established the Quarter corner of Sections 35 & 36 Township 36 North, Range 11 East Fourth Principal Meridian,



as described hereon; and that from this evidence I established a new monument and accessories as described hereon to perpetuate the original location of this corner.

Resident witnesses:

Glen Barker

Jim Claflin

Herb Wagoner

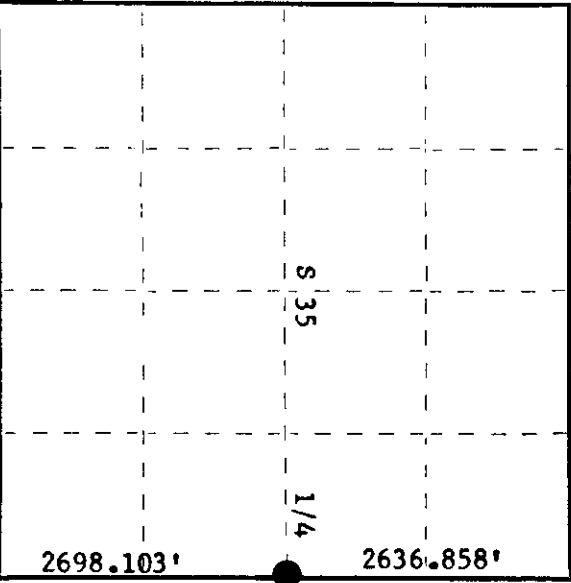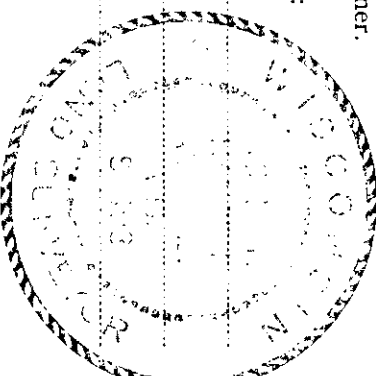

O = Corner monument restored.

History of original corner establishment:

Original corner established by William E. Dougherty, Deputy Surveyor, in 1859, from which pine 10" bears S 80° E, 30 links and spruce 8" bears S 51° W, 12 links.

Corner recovered by B.F. Dorr, County Surveyor, in 1906. Marked NBT - tamarack 11" S 67° W, 20 links

Description of corner evidence found:

No evidence of any corner recovered. Accepted the centerline of Pergande Road and old fence line west for location of corner. This point has been accepted by local land owners for many years.

Description of monument and accessories I established to perpetuate the original location of this corner. Set a 1 1/2" x 18" iron pipe in center of road for corner. Set a 2 1/2" Bernitsen A-1 Federal Monument S 45° W, 40 ft. for witness corner. Monument projects 10" above ground. Cap is stamped:

Marked NBT's to true corner--  
Red Pine 8" S 81° E 50.62 ft. T36N R11E  
Red Pine 10" S 41° E 53.46 ft. 1/4 35 + 36 W.C.  
Red Pine 8" S 34° W 63.62 ft. S498-1978  
Red Pine 4" N 49° W 54.97 ft. N 45° E 40 ft. to Cor.

Dated at Rhinelander, Wis., this 1st day of May, 1978.

Signature: Phillip T. Hansen, Title: Registered Land Surveyor, Registration No. S-498 (County Surveyor, Registered Land Surveyor, or other duly authorized official)

Office of Register of Deeds, County of Oneida, at 2:00 o'clock P.M. 15th day of May, 1978. I hereby certify that the within instrument was filed in this office for record on the 15th day of May, 1978.

Doris Verage Kuehn (Register of Deeds)

By Joseph M. Brown Deputy