

CERTIFIED LAND CORNER RESTORATION

Index No. **W. 21**

State of Wisconsin

County of Oneida

ss.

I Phillip T. Hansen, do hereby

certify that on the 19th day

established April, 1978, I ~~found~~

~~established~~ the N 1/16

corner of Sections 35 & 36

Township 36, North, Range

11 East, Fourth Principal Meridian,


as described hereon; and that from this evidence I established a new monument and accessories as described hereon to perpetuate the original location of this corner.

Resident witnesses:

Glen Barker

Jim Clafin


Herb Wagoner

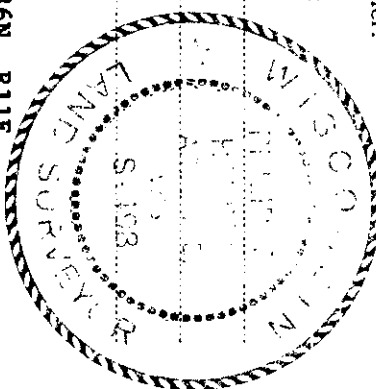

T36N R11E

N 1/16

35

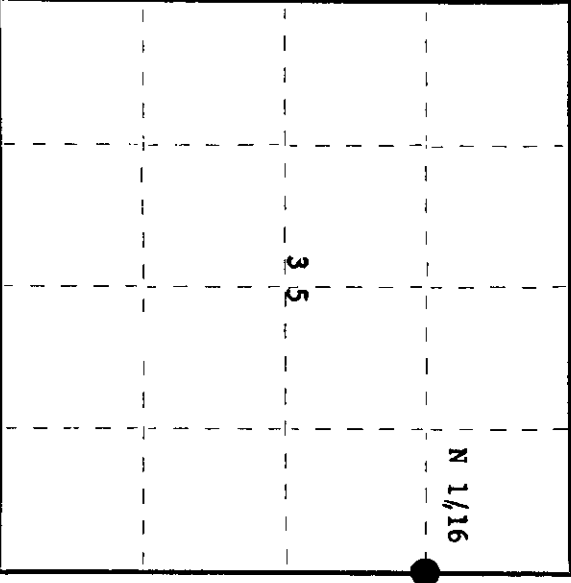

○ = Corner monument restored.

History of original corner establishment:

Corner established by B.F. Dorr, County Surveyor, in 1906. Marked Norway 1 1/2" S41°W, 21 links.

Description of corner evidence found:

No evidence of any corner recovered. Corner established by proportionate measurement by traverse. Ran traverse from re-established 1/4 corner between sections 35 & 36 to section corner 25, 26, 35 & 36. Computed distance 2636.858 ft. at bearing N 4° 29' 31" E. Set N 1/16 at 1318.429 ft. intermediate.

Description of monument and accessories I established to perpetuate the original location of this corner.

Drove a 1 1/2" x 18" iron pipe in centerline of Pergande Road 4" below the surface. Set 1 1/2" iron pipe with 2" brass cap 30 ft. west for witness corner. Monument projects 18" above ground, cap stamped: Marked NBT from true corner. Red Pine 4" S48°W, 42.2 ft., scribed 1/16 BT.

S498
T36N R11E
N 1/16 35 36 W.C.
CPI-1978
E 30 ft.

Dated at Rhineland, Wis., this 1st day of May, 1978.

Signature Phillip T. Hansen Title Registered Land Surveyor Registration No. S-498
(County Surveyor, Registered Land Surveyor, or other duly authorized official)

Office of Register of Deeds, County of Oneida. I hereby certify that the within instrument was filed in this office for record on the 15th day of May, 1978 at 2:15 o'clock P.M.

Doris Lange Kuehn
(Register of Deeds)

By Joseph M. Boerner Deputy