

CERTIFIED LAND CORNER RESTORATION

Index No. A-25

State of Wisconsin }  
County of Oneida } ss.



I Phillip T. Hansen, do hereby certify that on the 15th day of October, 1976, I found evidence of the Section corner of S 36, 31, 6, 1 Township 35 - 36, North, Range 11 & 12 East, Fourth Principal Meridian, as described hereon; and that from this evidence I established a new monument and accessories as described hereon to perpetuate the original location of this corner.

Resident witnesses:

Glen Barker

Jim Claflin

Herb Wagoner

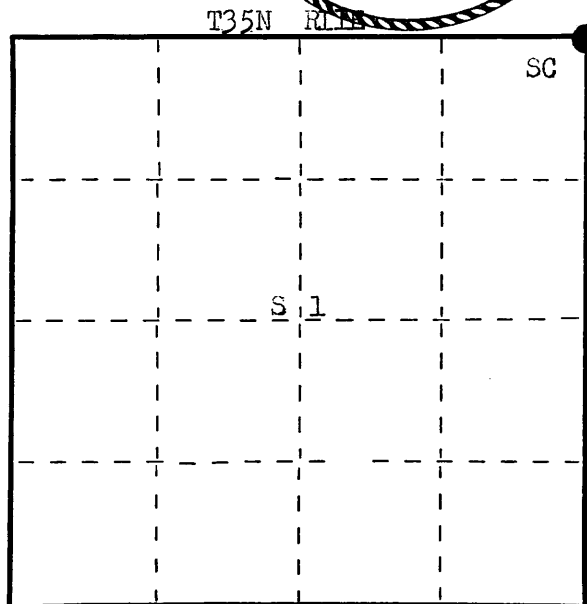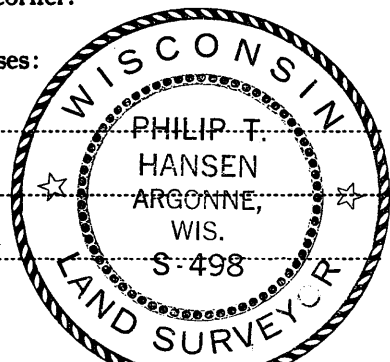

○ = Corner monument restored.

History of original corner establishment: Original Corner established by Alfred Millard, Deputy Surveyor, in 1857, from which Tamarack 10" bears N 4° E 21 links; Tamarack 10" bears N 45° W 25 links; Tamarack 11" bears S 40° W 19 links and Tamarack 10" bears S 38° E 11 links. This corner was re-established by J. Macon, Consolidated Forester, in 1946. Set 4" cedar post, squared and scribed. Found an old post claimed by local residents to have been the township corner, but observed no BTs. This corner is 74.60 chains north of Section Corner 1, 6, 7 and 12. Corner recovered by H.C. Lawrence, Registered Land Surveyor, in 1957. Set new post.

Description of corner evidence found:

Recovered Macon's old 4" cedar post, squared and scribed. Scribing S31 and 36 visible, down and covered with moss. Recovered Lawrence's 6" cedar post, squared and scribed S1 R11E, S6 T35N, S 31 R12E, S36 T36N. This also was laying down and partly covered with moss. Both points were recovered well preserved.

This is a willow and tag alder area with a few scattered black ash.

Description of monument and accessories I established to perpetuate the original location of this corner.

Set a 2 1/2" Berntsen A-1 Federal Monument in place of Lawrence's point. This is an aluminum pipe with magnet installed in cap and base. Cap stamped: Monument projects 8" above ground.

NBT - Black Ash 7" N 1° W 66 links, scribed SC BT.  
Set 3 NBO - 1 1/2" iron pipe, no caps, for reference corners.  
#1 South 20 links  
#2 West 15 links  
#3 East 25 links

Corner sets approximately 4 chains north of Wolf River.

R T36N R  
11 36 | 31 12  
E 1 | 6 E  
T35N  
S498-1976

Dated at Rhineland, Wis., this 23rd day of November, 1976.

Signature Phillip T. Hansen Title Registered Land Surveyor Registration No. S-498  
(County Surveyor, Registered Land Surveyor, or other duly authorized official)

Office of Register of Deeds, County of Oneida, I hereby certify that the within instrument was filed in this office for record on the 7th day of December, 1976 at 11:00 o'clock a M.

Doris Verage Kuehn  
(Register of Deeds)

By Joseph M. Boomer Deputy

FORM 985

361136000