

CERTIFIED LAND CORNER RESTORATION

Index No. A-23

State of Wisconsin }
County of Oneida } ss.


I Philip T. Hansen, do hereby certify that on the 15th day of October, 1976, I found evidence of the Quarter corner of Section 36 and 1 Township 36 and 1, North, Range 11 East, Fourth Principal Meridian, as described hereon; and that from this evidence I established a new monument and accessories as described hereon to perpetuate the original location of this corner.

Resident witnesses:


Glen Barker

Jim Claflin

Herb Wagoner

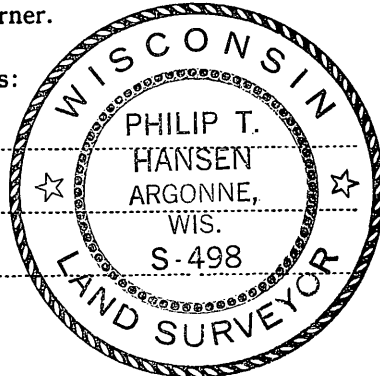

FORM 985
Wisconsin Printing & Publishing Co.
Milwaukee, Wisconsin

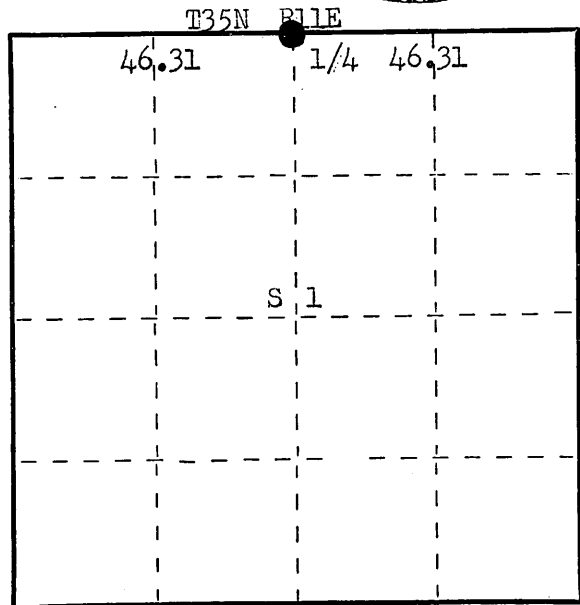

○ = Corner monument restored.

History of original corner establishment: Original Corner established by Hiram C. Fellows, Deputy Surveyor, in 1859, from which willow 6" bears N 15° E 19 links and tamarack 12" bears S 55° W 13 links. His measurement was 80.00 chains. Wm. E. Dougherty retraced this line the same year and measured 80.41 chains.

H.C. Lawrence, Registered Land Surveyor, retraced this line in 1957. From recovered corner at Sec. 35, 36, 1 & 2, he ran a random line S 89° 30' E and at 92.62 chains, closed out 4.72 chains north of Township Corner. Corrected bearing on line S 86° 40' E. Set 1/4 post at 46.31 chains intermediate and 2.32 chains south. Marked BTs - Cedar 7" S 47° W 42 1/2 links and Tamarack 5" N 59° E 55 1/2 links.

Description of corner evidence found:

Recovered 5" cedar post, squared and scribed 1/4 S S1, 1/4 S S36 in very poor condition.

Recovered OBT - Cedar 7" S 47° W (S 53° W) 42.5 links, scribed 1/4 S BT.
Tamarack 5" (8") N 59° E 55.5 links, scribed 1/4 S BT.

Description of monument and accessories I established to perpetuate the original location of this corner.

Replaced 5" cedar post with 2 1/2" Berntsen A-1 Federal Monument, aluminum with magnet installed in cap and base. Monument projects 18" above ground. Cap stamped:

Marked NBTs - Tamarack 10" N 2° W 40.2 links, scribed 1/4 BT.
Tamarack 9" S 76° W 10 links, scribed 1/4 BT.

T36N R11E
1/4 S | 36
S | 1
T35N R11E
S498 1976

Dated at Rhineland, Wis., this 29th day of November, 1976

Signature Philip T. Hansen Title Registered Land Surveyor Registration No. S-498
(County Surveyor, Registered Land Surveyor, or other duly authorized official)

Office of Register of Deeds, County of Oneida, I hereby certify that the within instrument was filed in this office for record on the 7th day of December, 1976 at 11:00 o'clock a M.

Doris Verage Kuehn
(Register of Deeds)

By Joseph M. Broemer Deputy

0200020
3611360020