

CERTIFIED LAND CORNER RESTORATION



Index No. **A-22**

State of Wisconsin }
 County of Oneida } ss.

I Philip T. Hansen, do hereby certify that on the 16th day of July, 1976, I found evidence of the 1/16 corner of sec. 1 and 36 Township 35 and 36, North, Range 11, East, Fourth Principal Meridian,

as described hereon; and that from this evidence I established a new monument and accessories as described hereon to perpetuate the original location of this corner.

Resident witnesses:
 Glen Parker
 Jim Martin
 Herb Wagner

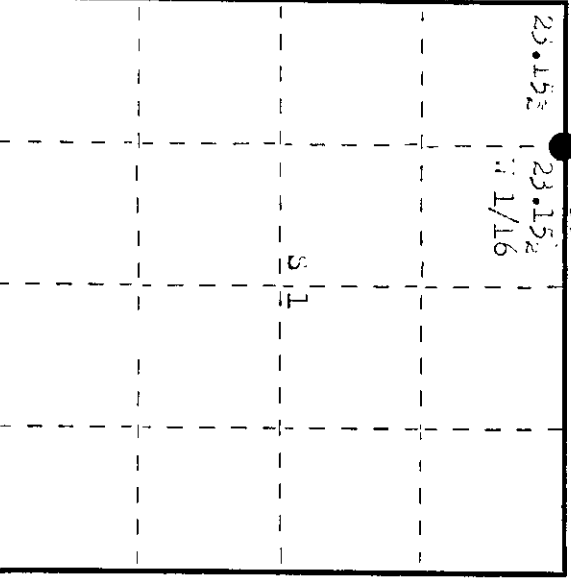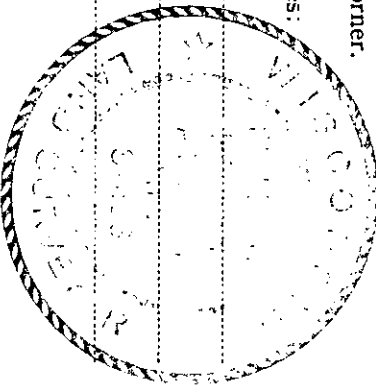

○ = Corner monument restored.

CERTIFIED LAND CORNER RESTORATION

History of original corner establishment: Corner set by proportion by H.C. Lawrence, registered land surveyor, in 1957. From the recovered corner, sec. 1-2, 35-36 he ran east (S 89° 30' E) 92.02 chains to a point 4.72 chains south to closing corner of Township corner. Recovered cedar post of unknown origin. Looked for evidence of original corner, but could find nothing. The original distance on this line was measured 80.41. Set cedar post at 23.152 chs. at corrected bearing S 86° 45' E at 1.10 chains south. Marked 5Ts - Tamarack 5" N 5 lks. Tamarack 5" S 20 W 3 1/2 lks.

Description of corner evidence found:
 Recovered 5" cedar post, squared and scribed " 1/16 DL, " 1/16 336. Post was leaning and in poor condition.

Recovered 5Ts - Tamarack 5" (6") North 5 lks (4.6 lks) scribed " 1/16 DT. Tamarack 5" (6") S 20 W (S 10 W) 3 1/2 lks, top scribing grown over.

Description of monument and accessories I established to perpetuate the original location of this corner. Replaced 5" cedar post with 1 1/2" iron pipe with brass cap stamped. Monument projects 18" above ground. DT - Tamarack 5" S 82° W 27.7 lks, scribed 1/16 DT. Monument and 5Ts painted blue.

T35N R11E
 3498
 " 1/16 336
 T35N R11E
 3498
 011-1976

Dated at Rhinelander, Wis. this 17th day of August, 1976

Signature: *Philip T. Hansen* Title: Registered Land Surveyor, or (County Surveyor, Registered Land Surveyor, or other duly authorized official) Registration No. 3498

Office of Register of Deeds, County of Oneida. I hereby certify that the within instrument was filed in this office for record on the 22nd day of September, 1976. at 1:00 o'clock P.M.

David Wayne Fischer
 (Register of Deeds)

By: _____ Deputy

3611360030