U.S. PUBLIC LAND SURVEY MONUMENT RECORD

Note: This form is intended and designed to fulfill all requirements of Wisconsin Administrative Code, Chapter A-E 7.08 U.S. Public Land Survey Monument Record (3)(a-i).

(a) CORNER LOCATION
1/4 Cor. of Secs. 1 & 6
Township 37 North
Range 4 & 5 East of the 4th P.M.
Town of Lynne/Little Rice
County of Oneida

WISCRS - Oneida County
N: 196,818.65 USft
E: 133,728.65 USft
Datum: NAD 83(2011)
GNSS Method: Real-Time Network
GNSS Control: WISCORS VRS

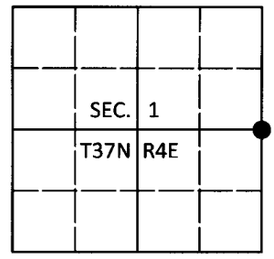

(b) HISTORY OF ORIGINAL CORNER ESTABLISHMENT

Original Surveyor: Alfred Millard

Date of Survey Commenced: Aug., 1860
Completed: Sep., 1860

Original Accessories:
Y. Birch 16 N5°E, 6 lks.
Hemlock 10 S25°W, 23 lks.

(b)(f)(g)(h) Description of monument found at this corner and if it was accepted, state all evidence (material, testimonial, occupational, plats, records, other monuments) used as a basis for accepting. If not accepted or if nothing was found, state evidence used as basis for establishing location. If re-established through lost corner proportionate methods, indicate all monuments, distances and directions used to establish. Indicate type of monument and sign post found or set.

December 17, 1937: Notes by Hall in CCC book 9 on page 31. "Find orig. West 1/4 S. as identified by Valley Imp. man in 1924. His post down fits @ 52 lks. S72°E from his Hem. and 23 lks. NE of an old Hem. (down). We set new cedar post."

June 15, 2017: Jeff Austin visited the corner and recovered a perpetuation of Hall's post, a 1-1/4" diam., 53" long bent iron pipe. The Valley Imp. hemlock stump bears N64°W, 52 lks. In place of the pipe, a 2-1/2" diam., 30" long aluminum pipe with a 3-1/4" diam. Oneida Co. aluminum cap projecting 2" above the ground surface was set. This location fits well when compared with Hall's measurements to the corners North and South. Accessories were found or established as shown below. A white vinyl sign post was set Southeast, 1 ft.

The coordinate value shown has been verified by at least one of the following methods: 1) comparison to a previously GPS determined published value; 2) the value is the average of two or more GPS observations at a markedly different time; 3) one or more distances were measured back to the GPS observed corner from temporary GPS observed offset locations.

(c)(d)(e) Plan view of corner with ties to at least 4 witness monuments. If in disagreement with previously established corner, show the distances between the two corners and also indicate the ties to the disputed.

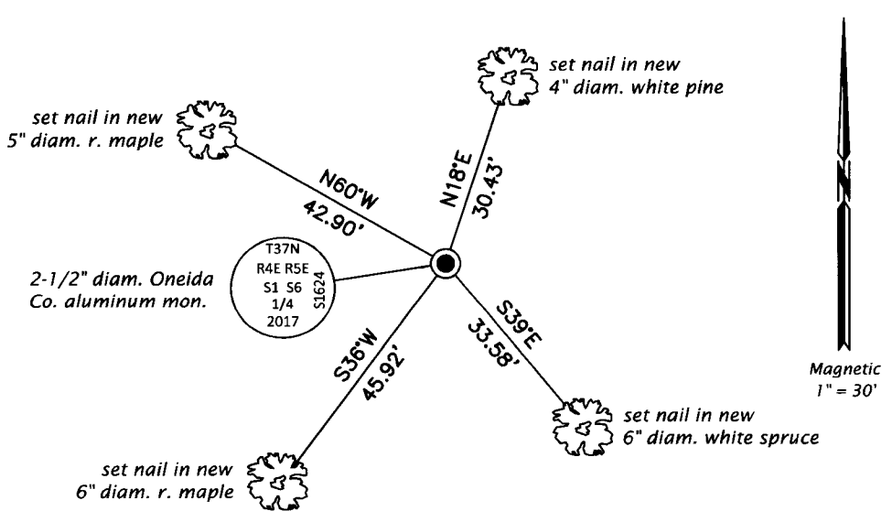

REGISTER OF DEEDS OFFICE
ONEIDA COUNTY
FILED

JUL 11 2017

AT_____O'CLOCK_____M
KYLE J. FRANSON
REGISTER OF DEEDS

(i) I, Michael J. Romportl, Professional Land Surveyor No. S-1624, hereby certify that the corner location on this record was determined by me or under my direction and control and that this U.S. Public Land Survey Monument Record is correct and complete to the best of my knowledge and belief.

WISCONSIN
MICHAEL J. ROMPORTL
S-1624
RHINELANDER, WI
LAND SURVEYOR

Michael J. Romportl 7/11/2017
Signature Date

3704012000 (INDEX NO. C-25)