


U.S. PUBLIC LAND SURVEY MONUMENT RECORD

Note: This form is intended and designed to fulfill all requirements of Wisconsin Administrative Code, Chapter A-8 7.08 U.S. Public Land Survey Monument Record (3)(a)(b)(c)(d)(e)(f)(g)(h)(i). An additional sheet may be added if necessary to conform with said requirements.

(a) CORNER LOCATION: State Plane Coordinates
N 1/4 corner of Sec. 11 X _____
 Township 37 North Y _____
 Range 4 East Datum Base _____
 Town/City Lynne County of Oneida

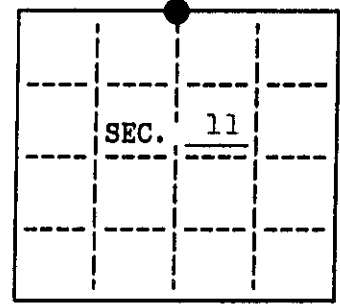


(b) HISTORY OF ORIGINAL CORNER ESTABLISHMENT
 Original Surveyor: Edward Palmer Original B.T.'s
 Date of Survey: Commenced Oct. 1864 hemlock 8 N68°W, 8 lks.
 Completed Oct. 1864 birch 13 S42°E, 24 lks.

(b)(f)(g)(h) Description of monument found at this corner and if it was accepted, state all evidence (material, testimonial, occupational, plats, records, other monuments) used as a basis for accepting. If not accepted or if nothing was found, state evidence used as basis for establishing location. If reestablished through lost corner proportionate methods, indicate all monuments, distances and directions used to establish. Indicate type of monument and sign post found or set.

October 12, 1938: CCC book 10, page 52; Crigl. 1/4 S between 2/11. BT stub has fallen, find hole in ground agreeing with record distance from stub & from remains of a hem. stump assumed as origl. Set new cedar post & mark: birch 18" N45°E, 47.4'; cedar 4" N89°E, 25.7'; maple 4" N53°W, 24.1'.

October 19, 1991: I found and accepted a 2-1/2" dia. iron pipe with a 2-1/2" dia. brass cap 33" above ground and marked as shown. I found the following witnesses: (CCC) scribed birch snag 20" N46°E, 48.5 feet; (CCC) cedar snag S87°E, 25.5 feet; (CCC) maple snag 14" N53°W, 24.6 feet. I established the following witnesses: set nail in doub. h.maple 9" N47°E, 27.94 feet; set nail in h.maple 8" S6°E, 22.62 feet; set nail in r.maple 11" S59°W, 27.57 feet; set nail in h.maple 8" N38°W, 39.42 feet; set plastic sign post Northeast, 1-1/2 feet.


(c)(d)(e) Plan view of corner with ties to at least 4 witness monuments. If in disagreement with previously established corner, show the distances between the two corners and also indicate the ties to the disputed.

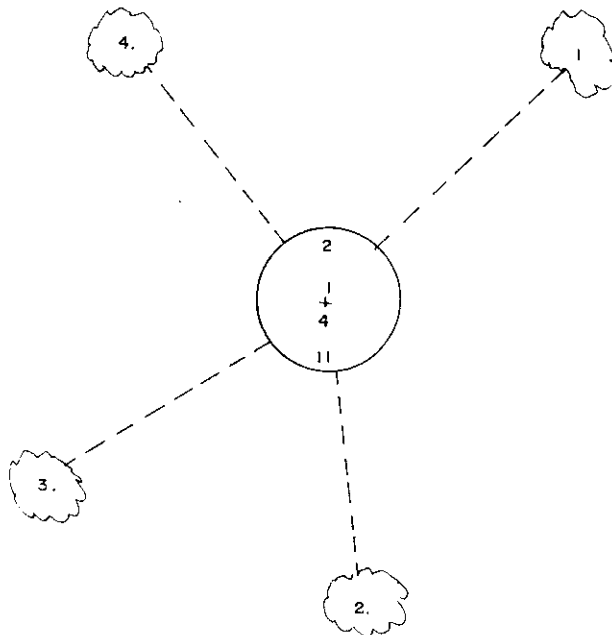

1. nail in doub.h.maple 9" N47°E, 27.94 feet
 2. nail in h.maple 8" S6°E, 22.62 feet
 3. nail in r.maple 11" S59°W, 27.57 feet
 4. nail in h.maple 8" N38°W, 39.42 feet
- not to scale

(i) I, Jeffrey W. Austin, Reg. Land Surveyor hereby certify that the corner location on this record was determined by me or under my direction and control and that this U.S. Public Land Survey Monument Record is correct and complete to the best of my knowledge and belief.

Signature *Jeffrey W. Austin* Date 10-28-1991

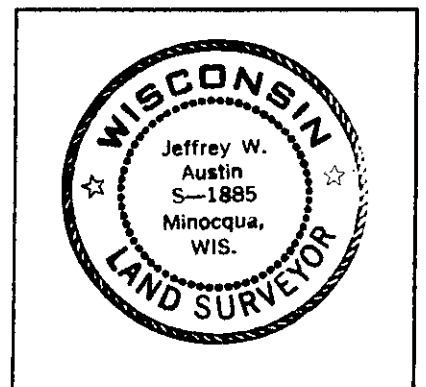

INDEX NO. E-19

3704020020