


U. S. PUBLIC LAND SURVEY MONUMENT RECORD

Note: This form is intended and designed to fulfill all requirements of Wisconsin Administrative Code, Chapter A-8 7.08 U.S. Public Land Survey Monument Record (3)(a)(b)(c)(d)(e)(f)(g)(h)(i). An additional sheet may be added if necessary to conform with said requirements.

(a) CORNER LOCATION: State Plane Coordinates
 SE corner of Sec. 3 X _____
 Township 37 North Y _____
 Range 4 East Datum Base _____
 Town/City Lynne County of Oneida

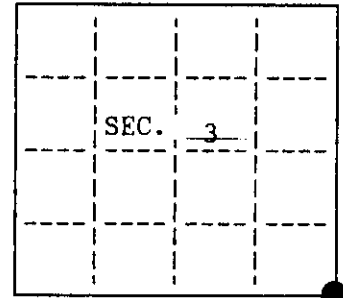


(b) HISTORY OF ORIGINAL CORNER ESTABLISHMENT Original B.T.'S
 Original Surveyor: Edward Palmer

Date of Survey: Commenced October, 1864 10" Hemlock N60°W, 22 lks.
 Completed October, 1864 14" Birch N45°E, 36 lks.
 6" Birch S57°E, 8 lks.
 7" Sugar S51°W, 18 lks.

(b)(f)(g)(h) Description of monument found at this corner and if it was accepted, state all evidence (material, testimonial, occupational, plats, records, other monuments) used as a basis for accepting. If not accepted or if nothing was found, state evidence used as basis for establishing location. If reestablished through lost corner proportionate methods, indicate all monuments, distances and directions used to establish. Indicate type of monument and sign post found or set.

- March, 1934 - CCC Book 3, Page 32 indicates SW corner of Section 2 is original. Small hub found for corner and original Hemlock is down, marks OK. No others visible.
- December, 1963 - Notes by Nekoosa Papers indicates corner is in place "by others."
- June 29, 1994 - I found and accepted a wood post hole and rotted post remains closely agreeing with the Nekoosa survey measurements. I found a rotted Hemlock stump N60°W, 14.5 feet. I witnessed the monument as shown below and set a plastic signpost north 1 foot.

(c)(d)(e) Plan view of corner with ties to at least 4 witness monuments. If in disagreement with previously established corner, show the distances between the two corners and also indicate the ties to the disputed.

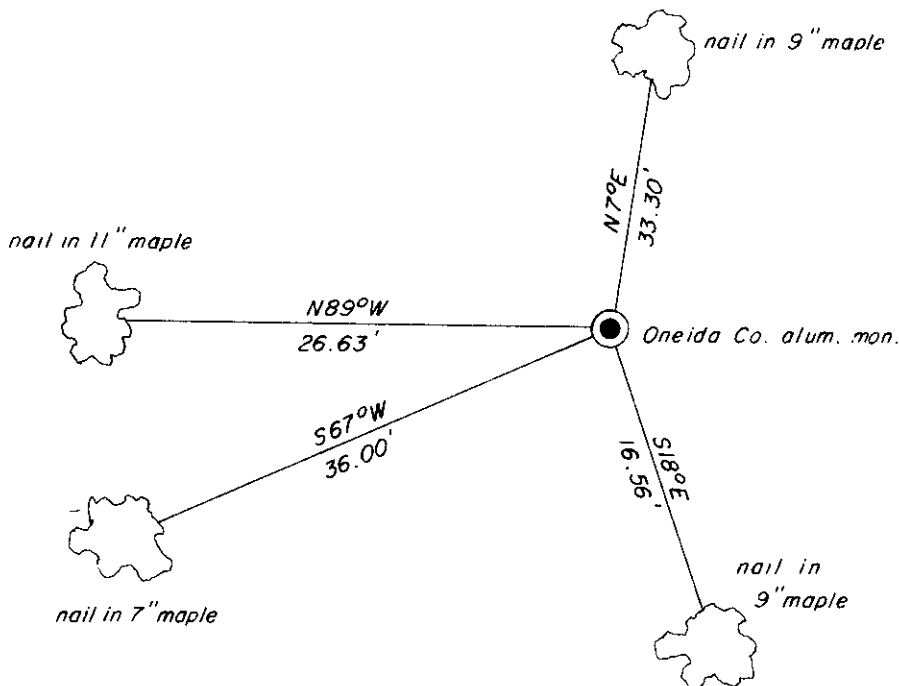

Not to Scale



INDEX NO. E-17

(i) I, Jeffrey W. Austin, Registered Land Surveyor hereby certify that the corner location on this record was determined by me or under my direction and control and that this U.S. Public Land Survey Monument Record is correct and complete to the best of my knowledge and belief.

Signature: *[Handwritten Signature]* Foltz & Associates, Inc. Date: 9-27-94

3704030000