U.S. PUBLIC LAND SURVEY MONUMENT RECORD

Note: This form is intended and designed to fulfill all requirements of Wisconsin Administrative Code, Chapter A-E 7.08 U.S. Public Land Survey Monument Record (3) (a) (b) (c) (d) (e) (f) (g) (h) (i). An additional sheet may be added if necessary to conform with said requirements.

(a) Corner location: Township 37 North

Range 4 East/~~West~~

Town/~~City~~/~~Village~~ Lynne

County Oneida

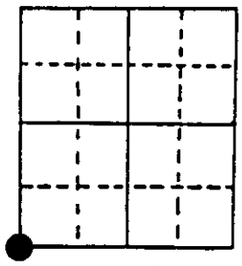

Section 10

(b) (f) (g) (h) Description of monument found at this corner and if it was accepted, state all evidence (material, testimonial, occupational, plats, records, other monuments) used as a basis for accepting. If not accepted or if nothing was found, state evidence used as basis for establishing location. If reestablished through lost corner proportionate methods, indicate all monuments, distances and directions used to establish. Indicate type of monument found or set and sign post.

10/1864 - Edward D. Palmer established this corner and set a wood post with BTs:
6" Tamarack, N70°E, 15 Links
4" Tamarack, S62°W, 4 Links
4" Cedar, S42°E, 16 Links
7" Birch, N12°W, 12 Links

3/20/1991 - Milo E. Stefan found 2" x 60" iron pipe with brass cap, a 3/4" x 4' high iron pipe and a lot corner slat. This position is the perpetuated position of the original corner by Palmer. I made new BTs and set plastic sign post.

(c) (d) (e) Plan view of corner with ties to at least 4 witness monuments. If in disagreement with previously established corner, show the distances between the two corners and also indicate the ties to the disputed corner.

1) 2" x 60" iron pipe/brass cap
*2) 10" Tamarack, N15°E, 37.42'
3) 6" Black Spruce, N83°E, 40.25'
4) 6" Red Maple, S45°W, 34.40'
5) 8" Tamarack, N51°W, 29.04'
6) Plastic sign post, Northwest, .1'

Distances to nail in side of BTs.
Stump blazes scribed "BT".
*W.C.D. Location Poster on face of this BT with stump blaze overgrown, not rescribed.

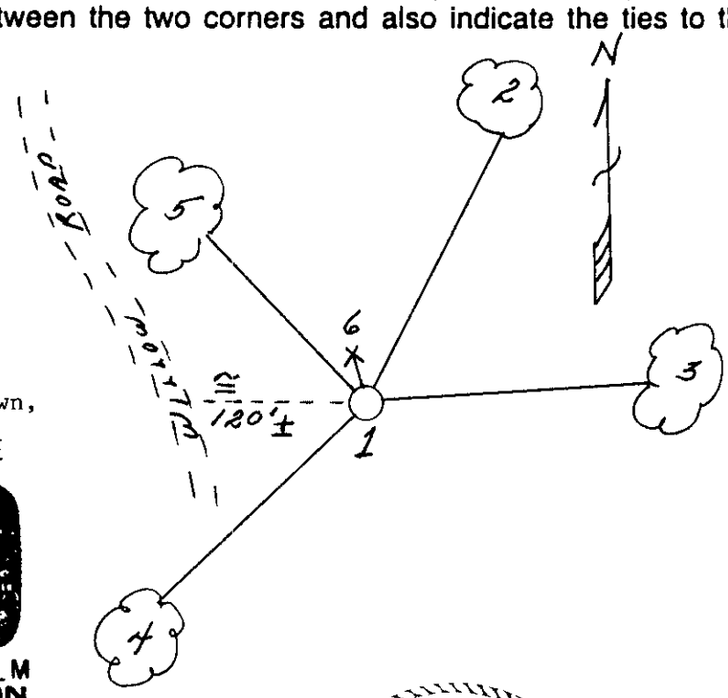

REGISTER OF DEEDS OFFICE
ONEIDA COUNTY, WIS.
FILED
APR 8 1991
At _____ O'Clock _____ M
THOMAS H. LEIGHTON
REGISTER OF DEEDS

(i) I, Milo E. Stefan (type or print name) certify that the corner location on this record was determined by me or under my direction and control and that this U.S. Public Land Survey Monument Record is correct and complete to the best of my knowledge and belief.

Milo E. Stefan — March 22, 1991

Signature — Date

WISCONSIN MILO E. STEFAN S-1558 RHINELANDER, WIS. LAND SURVEYOR

Index No. J-13

Stamp 3704090000