

U.S. PUBLIC LAND SURVEY MONUMENT RECORD


Note: This form is intended and designed to fulfill all requirements of Wisconsin Administrative Code, Chapter A-E 7.08 U.S. Public Land Survey Monument Record (3) (a) (b) (c) (d) (e) (f) (g) (h) (i). An additional sheet may be added if necessary to conform with said requirements.

(a) Corner location: Township 37 North

Range 4 East/West

Town/City/Village Lynne

County Oneida

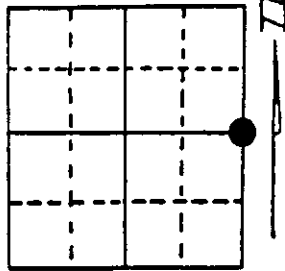

Section 13

(b) (f) (g) (h) Description of monument found at this corner and if it was accepted, state all evidence (material, testimonial, occupational, plats, records, other monuments) used as a basis for accepting. If not accepted or if nothing was found, state evidence used as basis for establishing location. If reestablished through lost corner proportionate methods, indicate all monuments, distances and directions used to establish. Indicate type of monument found or set and sign post.

9/7/1860 - Alfred Millard established this corner and at 40.00 chains set a wood post and two BTs:

16" Red Pine, S30°E, 12 Links (7.92')

8" Spruce, S40°W, 16 Links (10.56')


10/15/1934 - A.J. Lytle measured distance between Section Corners North and South and found to be 80.76 chains. He restored this corner at midpoint and on line at 40.38 chains. No bearing trees were made.

7/21/1994 - Milo E. Stefan found 2" x 60" iron pipe/brass cap stamped to identify corner. We made four new BTs and set sign post.

(c) (d) (e) Plan view of corner with ties to at least 4 witness monuments. If in disagreement with previously established corner, show the distances between the two corners and also indicate the ties to the disputed corner.

- 1) 2" x 60" Iron Pipe/Brass Cap.
- 2) 5" Black Spruce, N15°E, 11.41'.
- 3) 6" Black Spruce, N78°E, 31.92'.
- 4) 2" Black Spruce, S9°W, 18.80'.
- 5) 4" Red Maple, N11°W, 4.67'.
- 6) Plastic Sign Post, East, 1.0'.

Distances to nail in side of BTs.
Stump blaze scribed "BT".

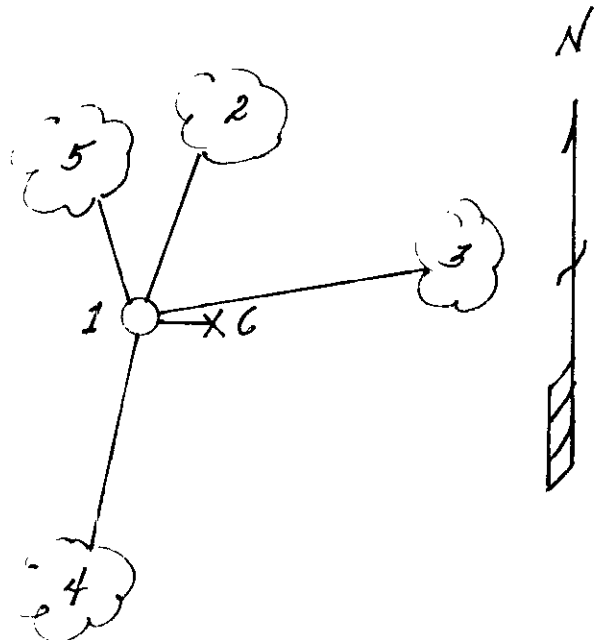

(i) I, Milo E. Stefan

(type or print name) certify that the corner location on this record was determined by me or under my direction and control and that this U.S. Public Land Survey Monument Record is correct and complete to the best of my knowledge and belief.

Milo E. Stefan
Signature

July 25, 1994
Date



Index No. L-25

Stamp 3704132000