# U.S. PUBLIC LAND SURVEY MONUMENT RECORD

Note: This form is intended and designed to fulfill all requirements of Wisconsin Administrative Code, Chapter A-E 7.08 U.S. Public Land Survey Monument Record (3) (a) (b) (c) (d) (e) (f) (g) (h) (i). An additional sheet may be added if necessary to conform with said requirements.

(a) CORNER LOCATION:
1/4 Cor. of Secs. 19 & 30
Township 37 North
Range 4 East of the 4th P.M.
Town of Lynne

Oneida County Coordinates
N: 178,073.249 USft
E: 104,745.858 USft
Datum: NAD 1983(1991)
County of Oneida

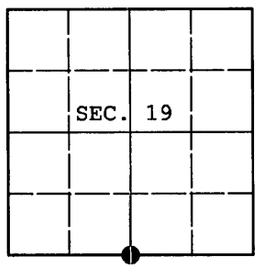


(b) HISTORY OF ORIGINAL CORNER ESTABLISHMENT

Original Surveyor: Edward D. Palmer
Date of Survey: Commenced: Oct. 4, 1864
Completed: Oct. 13, 1864

Original Accessories:
hemlock 8" N39°E, 9 lks.
hemlock 7" S14°W, 14 lks.

(b) (f) (g) (h) Description of monument found at this corner and if it was accepted, state all evidence (material, testimonial, occupational, plats, records, other monuments) used as a basis for accepting. If not accepted or if nothing was found, state evidence used as basis for establishing location. If re-established through lost corner proportionate methods, indicate all monuments, distances and directions used to establish. Indicate type of monument and sign post found or set.

November 29, 2012: An extensive search for evidence of the General Land Office survey and any subsequent resurveys mentioned above was performed. Having found none, the corner was positioned by proportionate measure as shown on map number C-2776 filed in the office of the Oneida County Surveyor. The GLO topographic calls were also evaluated to confirm the validity of the position. At the corner point a 2-1/2" diam., 30" long aluminum pipe with 3-1/4" diam. Oneida County aluminum cap projecting 5" above the ground surface was set. Accessories were established as shown below and a white plastic sign post bears Southeast, 1 ft. dist.

The coordinates shown were derived from two independent RTK observations of the corner point and are based on the WISCORS network.

(c) (d) (e) Plan view of corner with ties to at least 4 witness monuments. If in disagreement with previously established corner, show the distances between the two corners and also indicate the ties to the disputed.

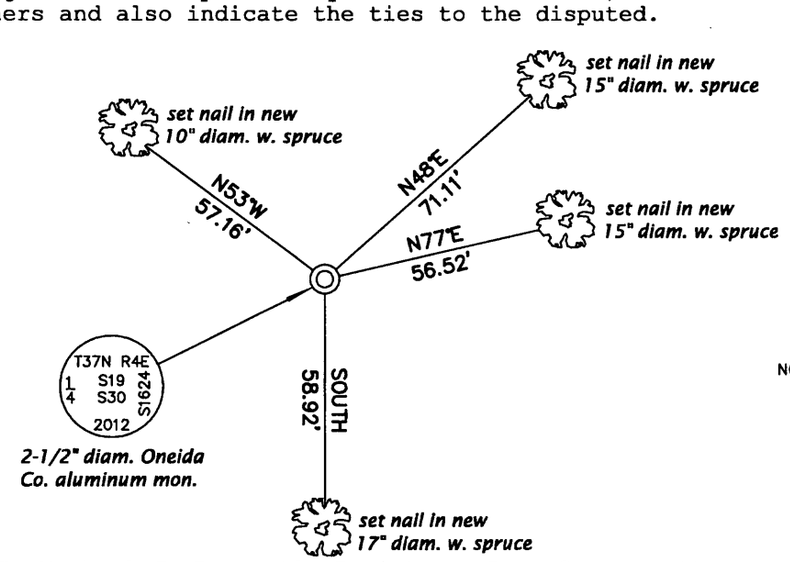


NO SCALE

REGISTER OF DEEDS OFFICE
ONEIDA COUNTY
FILED

APR 15 2013

AT _____ O'CLOCK _____ M
KYLE J. FRANSON
REGISTER OF DEEDS

(i) I, Michael J. Romportl, Registered Land Surveyor No. S-1624, hereby certify that the corner location on this record was determined by me or under my direction and control and that this U.S. Public Land Survey Monument Record is correct and complete to the best of my knowledge and belief.

WISCONSIN
MICHAEL J. ROMPORTL
S-1624
RHINELANDER, WI
LAND SURVEYOR

Michael J Romportl
Signature

2/12/2013
Date

3704190020 (INDEX NO. R-3)