


U. S. PUBLIC LAND SURVEY MONUMENT RECORD

Note: This form is intended and designed to fulfill all requirements of Wisconsin Administrative Code, Chapter A-B 7.08 U.S. Public Land Survey Monument Record (3)(a)(b)(c)(d)(e)(f)(g)(h)(i). An additional sheet may be added if necessary to conform with said requirements.

(a) CORNER LOCATION: State Plane Coordinates
 SE corner of Sec. 22 X _____
 Township 37 North Y _____
 Range 4 East Datum Base _____
 Town/City Lynne County of Oneida

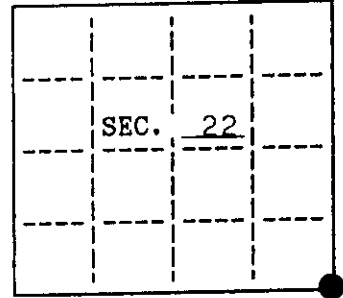

(b) HISTORY OF ORIGINAL CORNER ESTABLISHMENT
 Original Surveyor: Edward Palmer Original B.T.'s
 Date of Survey: Commenced Oct. 1864
 Completed Oct. 1864


birch 12 N24°W, 13 lks.
 sugar 10 N60°E, 9 lks.
 hemlock 12 S38°E, 24 lks.
 w.pine 24 S22°W, 9 lks.

(b)(f)(g)(h) Description of monument found at this corner and if it was accepted, state all evidence (material, testimonial, occupational, plats, records, other monuments) used as a basis for accepting. If not accepted or if nothing was found, state evidence used as basis for establishing location. If reestablished through lost corner proportionate methods, indicate all monuments, distances and directions used to establish. Indicate type of monument and sign post found or set.

September, 1934: Notes by Lytle: 80+02 found orig. cor. to Secs. 22-23-26-27 fell S. 4.56 corrected var. put in new P. marked up new bearings (w.pine 22 N20°W, 68 lks., maple 15 S21°E, 58-3/4)

October 16, 1991: I found and accepted a 3" dia. hole in ground with wood fragments inside. In this hole, I set a 2-1/2" dia. 30" long aluminum pipe with 3-1/4" dia. Oneida Co. aluminum cap set 7" above ground and marked as shown. I also set a Deep-1 magnet beneath the pipe. I found the following witnesses: (GLO) rotted pine stump S23°W, 6.0 feet; (Lytle) maple stump 18" S8°E, 38.8 feet; (Lytle) set nail in scribed w.pine 26" N19°W, 46.95 feet. I established the following witnesses: set nail in w.pine 27" S29°E, 109.15 feet; set nail in w.pine 7" S52°W, 36.90 feet; set nail in w.pine 9" N78°W, 56.05 feet; set plastic sign post West, 1-1/2


(c)(d)(e) Plan view of corner with ties to at least 4 witness monuments. If in disagreement with previously established corner, show the distances between the two corners and also indicate the ties to the disputed.

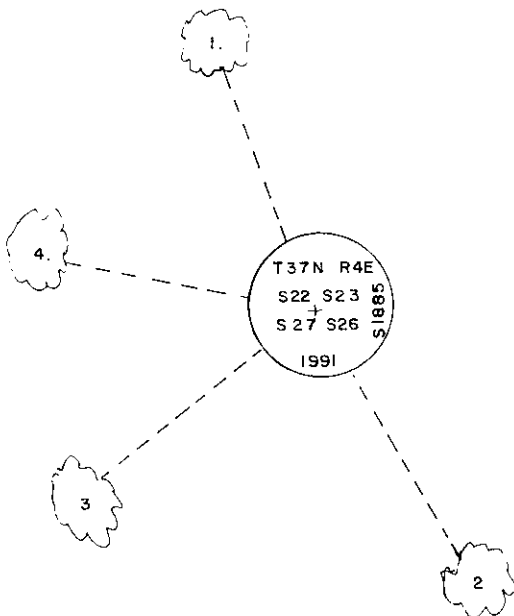

1. nail in w.pine 26" N19°W, 46.95 feet
 2. nail in w.pine 27" S29°E, 109.15 feet
 3. nail in w.pine 7" S52°W, 36.90 feet
 4. nail in w.pine 9" N78°W, 56.05 feet
- not to scale

(i) I, Jeffrey W. Austin, Reg. Land Surveyor hereby certify that the corner location on this record was determined by me or under my direction and control and that this U.S. Public Land Survey Monument Record is correct and complete to the best of my knowledge and belief.

Signature [Handwritten Signature] Date 10-28-1991

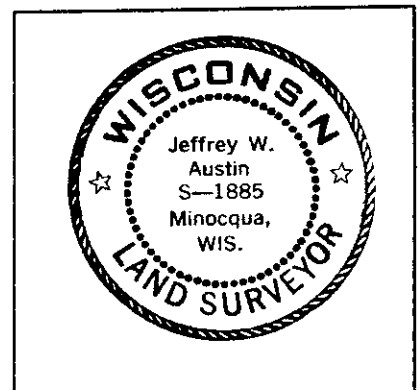

INDEX NO. R-17

3704220000