U.S. PUBLIC LAND SURVEY MONUMENT RECORD

Note: This form is intended and designed to fulfill all requirements of Wisconsin Administrative Code, Chapter A-E 7.08 U.S Public Land Survey Monument Record (3) (a) (b) (c) (d) (e) (f) (g) (h) (i). An additional sheet may be added if necessary to conform with said requirements.

(a) Corner location: Township 37 North

Range 4 East/West

Town/City/Village Lynne

County Oneida

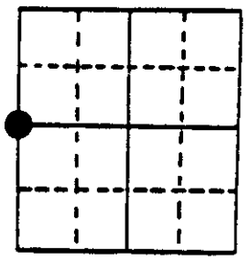

Section 24

(b) (f) (g) (h) Description of monument found at this corner and if it was accepted, state all evidence (material, testimonial, occupational, plats, records, other monuments) used as a basis for accepting. If not accepted or if nothing was found, state evidence used as basis for establishing location. If reestablished through lost corner proportionate methods, indicate all monuments, distances and directions used to establish. Indicate type of monument found or set and sign post.

10/1864 - Edward D. Palmer established this corner and set a wood post and BTs:
16" Birch, N70°E, 12 Links 9" Hemlock, N39°W, 23 Links

4/25/1989 - Romportl and crew placed target over 2" x 60" brass capped monument (not stamped).

3/14/1991 - Milo E. Stefan accepted this monument as the perpetuated corner position and restored same.

(c) (d) (e) Plan view of corner with ties to at least 4 witness monuments. If in disagreement with previously established corner, show the distances between the two corners and also indicate the ties to the disputed corner.

1) 2" x 60" iron pipe/brass cap
2) 6" Sugar Maple, N11°E, 28.71 feet
3) 10" Sugar Maple, S64°E, 66.66 feet
4) 10" Red Pine, S13°W, 44.00 feet
5) 10" Red Pine, N17°W, 33.10 feet
6) Plastic sign post, South, .5 feet

Distances to nail on side of BTs
Stump blazes scribed "BT"

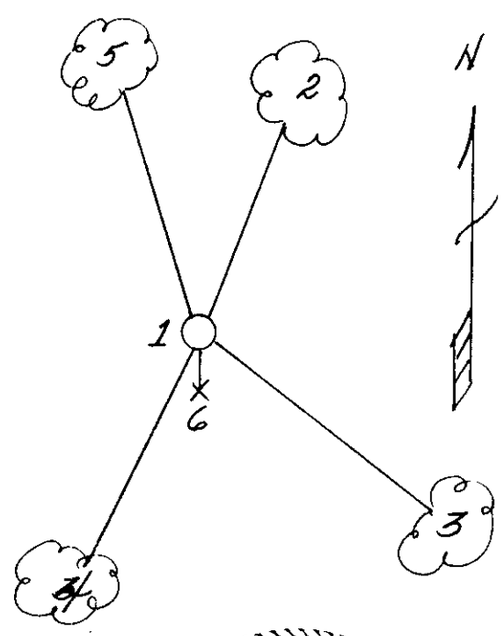

REGISTER OF DEEDS OFFICE
ONEIDA COUNTY, WIS.
FILED
APR 8 1991
At _____ O'Clock _____ M
THOMAS H. LEIGHTON
REGISTER OF DEEDS

(i) I, Milo E. Stefan (type or print name) certify that the corner location on this record was determined by me or under my direction and control and that this U.S. Public Land Survey Monument Record is correct and complete to the best of my knowledge and belief.

Milo E. Stefan — March 16, 1991

Signature — Date

WISCONSIN MILO E STEFAN S-2058 RHINELANDER, WIS. LAND SURVEYOR

Index No. P-21

3704232000