U.S. PUBLIC LAND SURVEY MONUMENT RECORD

Note: This form is intended and designed to fulfill all requirements of Wisconsin Administrative Code, Chapter A-E 7.08 U.S. Public Land Survey Monument Record (3) (a) (b) (c) (d) (e) (f) (g) (h) (i). An additional sheet may be added if necessary to conform with said requirements.

(a) Corner location: Township 37 North

Range 4 East/West

Town/City/Village Lynne

County Oneida

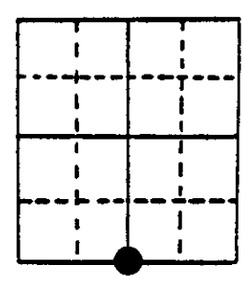

Section 24

(b) (f) (g) (h) Description of monument found at this corner and if it was accepted, state all evidence (material, testimonial, occupational, plats, records, other monuments) used as a basis for accepting. If not accepted or if nothing was found, state evidence used as basis for establishing location. If reestablished through lost corner proportionate methods, indicate all monuments, distances and directions used to establish. Indicate type of monument found or set and sign post.

10/1864 - Edward D. Palmer established this corner and set a wood post with BTs:
14" Hemlock, S70°E, 10 Links 10" Birch, N57°W, 38 Links

1940's - A. J. Lytle re-established this corner and set a 2" x 60" iron pipe/pipe cap stamped to identify corner. No record of BTs.

3/14/1991 - Milo E. Stefan found Lytle's monument and Pine Snag, scribed 1/4S, S6E, 45.70 feet. I accepted this corner as the perpetuated location of the original corner and restored same.

(c) (d) (e) Plan view of corner with ties to at least 4 witness monuments. If in disagreement with previously established corner, show the distances between the two corners and also indicate the ties to the disputed corner.

1) 2" x 60" iron pipe/pipe cap
2) 10" White Birch, N45°E, 35.90 feet
3) 6" Balsam Fir, S11°E, 39.25 feet
*4) 20" White Pine Snag, S6°E, 45.70 feet
5) 5" Red Maple, N80°W, 40.68 feet
6) Plastic sign post, East, 1.0 feet

Distances to nail on side of BTs
Stump blazes scribed "BT"
*Distance to face of snag

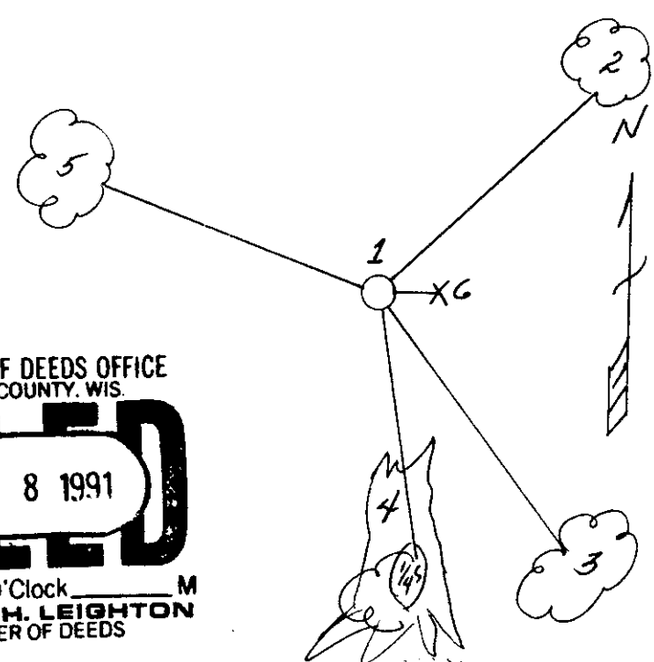

REGISTER OF DEEDS OFFICE
ONEIDA COUNTY, WIS.
FILED
APR 8 1991
At _____ O'Clock _____ M
THOMAS H. LEIGHTON
REGISTER OF DEEDS

(i) I, Milo E. Stefan (type or print name) certify that the corner location on this record was determined by me or under my direction and control and that this U.S. Public Land Survey Monument Record is correct and complete to the best of my knowledge and belief.

Milo E. Stefan — March 16, 1991

Signature — Date

MILO E. STEFAN S-1558 RHINELANDER, WIS. LAND SURVEYOR

3704240020

Stamp

Index No. R-23