

U.S. PUBLIC LAND SURVEY MONUMENT RECORD


Note: This form is intended and designed to fulfill all requirements of Wisconsin Administrative Code, Chapter A-E 7.08 U.S. Public Land Survey Monument Record (3) (a) (b) (c) (d) (e) (f) (g) (h) (i). An additional sheet may be added if necessary to conform with said requirements.

(a) Corner location: Township 37 North

Range 4 East/West

Town/City/Village Lynne

County Oneida

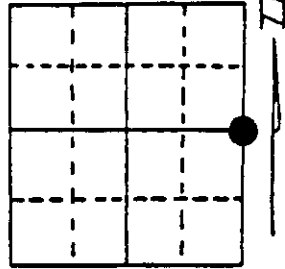

Section 24

(b) (f) (g) (h) Description of monument found at this corner and if it was accepted, state all evidence (material, testimonial, occupational, plats, records, other monuments) used as a basis for accepting. If not accepted or if nothing was found, state evidence used as basis for establishing location. If reestablished through lost corner proportionate methods, indicate all monuments, distances and directions used to establish. Indicate type of monument found or set and sign post.

9/7/1860 - Alfred Millard established this corner at 40.00 chains and set a wood post with two BTs:

- 10" Hemlock, N30°E, 10 Links (6.60')
- 12" Hemlock, N47°W, 18 Links (11.88')

10/12/1934 - A.J. Lytle found corner at 40.22 3/4 chains from the Section Corner South. He found stumps of both original BTs. and made two new BTs:


- 6" Balsam Fir, N26 1/2°E, 23 Links (15.18')
- 40" White Pine Stump, S55°W, 73 1/2 Links (48.51')

7/21/1994 - Milo E. Stefan found 2" x 60" iron pipe with brass cap and stump of Lytles Fir BT. The Pine Stump is under a bulldozer pile of earth from the Pine plantation. We made new BTs and set sign post.

(c) (d) (e) Plan view of corner with ties to at least 4 witness monuments. If in disagreement with previously established corner, show the distances between the two corners and also indicate the ties to the disputed corner.

- 1) 2" x 60" Iron Pipe/Brass Cap.
- 2) 6" Sugar Maple, N42°E, 21.75'.
- 3) 6" Sugar Maple, N80°E, 4.10'.
- 4) 22" White Pine, S48°E, 12.95'.
- 5) 5" Balsam Fir, S19°W, 13.03'.
- 6) Plastic Sign Post, East, .55'.

Distances to nail in side of BTs.
Stump blaze scribed "BT".

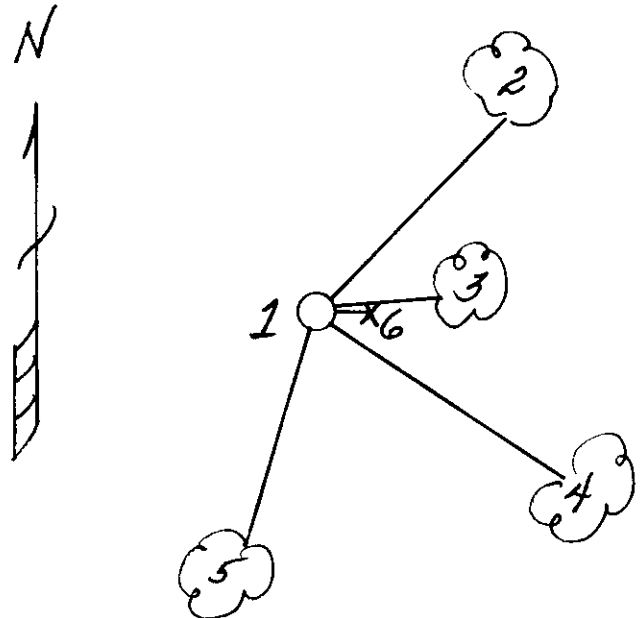

(i) I, Milo E. Stefan
(type or print name) certify that the corner location on this record was determined by me or under my direction and control and that this U.S. Public Land Survey Monument Record is correct and complete to the best of my knowledge and belief.

Milo E. Stefan
Signature

July 25, 1994
Date



3704242000
Stamp

Index No. P-25