


U.S. PUBLIC LAND SURVEY MONUMENT RECORD

Note: This form is intended and designed to fulfill all requirements of Wisconsin Administrative Code, Chapter A-E 7.08 U.S. Public Land Survey Monument Record (3) (a) (b) (c) (d) (e) (f) (g) (h) (i). An additional sheet may be added if necessary to conform with said requirements.

(a) Corner location: Township 37 North
 Range 4 East/West

Town/City/Village Lynne

County Oneida

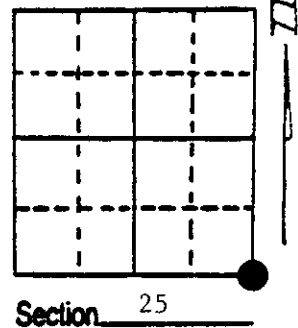

(b) (f) (g) (h) Description of monument found at this corner and if it was accepted, state all evidence (material, testimonial, occupational, plats, records, other monuments) used as a basis for accepting. If not accepted or if nothing was found, state evidence used as basis for establishing location. If reestablished through lost corner proportionate methods, indicate all monuments, distances and directions used to establish. Indicate type of monument found or set and sign post.

1860 - Alfred Millard established this corner and set a wood post and BTs:
 10" Hemlock, N75°E, 3 Links 10" Y. Birch, S32°W, 13 Links
 10" Hemlock, S35°E, 9 Links 15" Y. Birch, N30°W, 26 Links

1940's - A. J. Lytle restored corner and placed a 2" x 60" iron pipe with brass pipe cap stamped to identify corner.


4/1989 - Romportl and crew located corner and placed plastic target and sign post.

3/14/1991 - Milo E. Stefan found monument and restored corner by making four new BTs.

(c) (d) (e) Plan view of corner with ties to at least 4 witness monuments. If in disagreement with previously established corner, show the distances between the two corners and also indicate the ties to the disputed corner.

- 1) 2" x 60" iron pipe/brass pipe cap
- 2) 9" Red Maple, N49°E, 21.70 feet
- 3) 7" Sugar Maple, S44°E, 40.93 feet
- 4) 10" Red Maple, S29°W, 12.15 feet
- 5) 8" Red Maple, N83°W, 51.97 feet
- 6) Plastic sign post, East, 2.0 feet

Distances to nail in side of BTs
 Stump blazes scribed "BT"

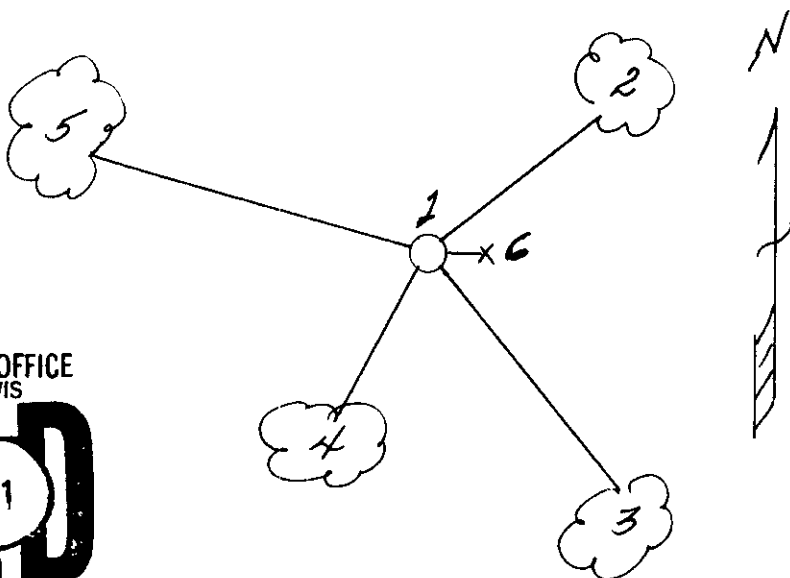

REGISTER OF DEEDS OFFICE
 ONEIDA COUNTY, WIS
FILED
 APR 8 1991
 At _____ O'Clock _____ M
THOMAS H. LEIGHTON
 REGISTER OF DEEDS



(i) I, Milo E. Stefan
 (type or print name) certify that the corner location on this record was determined by me or under my direction and control and that this U.S. Public Land Survey Monument Record is correct and complete to the best of my knowledge and belief.

Milo E. Stefan
 Signature

March 16, 1991
 Date

3704250000
 Stamp

Index No. V-25