U.S. PUBLIC LAND SURVEY MONUMENT RECORD

Note: This form is intended and designed to fulfill all requirements of Wisconsin Administrative Code, Chapter A-E 7.08 U.S. Public Land Survey Monument Record (3)(a)(b)(c)(d)(e)(f)(g)(h)(i). An additional sheet may be added if necessary to conform with said requirements.

(a) CORNER LOCATION:
1/4 Cor. of Secs. 6 & 31
Township 36 & 37 North
Range 4 East of the 4th P.M.
Town of Lynne

Oneida County Coordinates
N: 167,466.258 USft
E: 105,038.150 USft
Datum: NAD 1983(1991)
County of Oneida

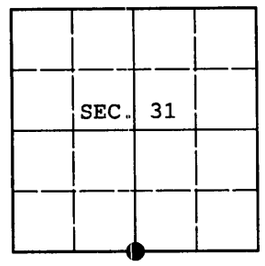

(b) HISTORY OF ORIGINAL CORNER ESTABLISHMENT

Original Surveyor: Alexander Anderson
Date of Survey: Commenced: July 13, 1864
Completed: July 24, 1864

Original Accessories:
spruce 6" S60°W, 13 lks.
spruce 6" N30°W, 34 lks.

(b)(f)(g)(h) Description of monument found at this corner and if it was accepted, state all evidence (material, testimonial, occupational, plats, records, other monuments) used as a basis for accepting. If not accepted or if nothing was found, state evidence used as basis for establishing location. If re-established through lost corner proportionate methods, indicate all monuments, distances and directions used to establish. Indicate type of monument and sign post found or set.

February 14, 1939: Notes by Gobler in Book 97 on Page 22 indicate he found the original corner evidenced by the Northwest GLO bearing tree. He set a new tamarack stake witnessed by: spruce 3" S8°W, 9 ft. and spruce 3" N20°W, 22 ft.

October 1, 2012: An extensive search for evidence of the General Land Office survey and any subsequent resurveys mentioned above was performed. Having found none, the corner was positioned by proportionate measure as shown on map number C-2776 filed in the office of the Oneida County Surveyor. The GLO topographic calls were also evaluated to confirm the validity of the position. At the corner point a 2-1/2" diam., 60" long aluminum pipe with 3-1/4" diam. Oneida County aluminum cap projecting 6" above the bog surface was set. Accessories were established as shown below and a white plastic sign post bears Northwest, 1 ft. dist.

The coordinates shown were derived from two independent RTK observations of the corner point and are based on the WISCORS network.

(c)(d)(e) Plan view of corner with ties to at least 4 witness monuments. If in disagreement with previously established corner, show the distances between the two corners and also indicate the ties to the disputed.

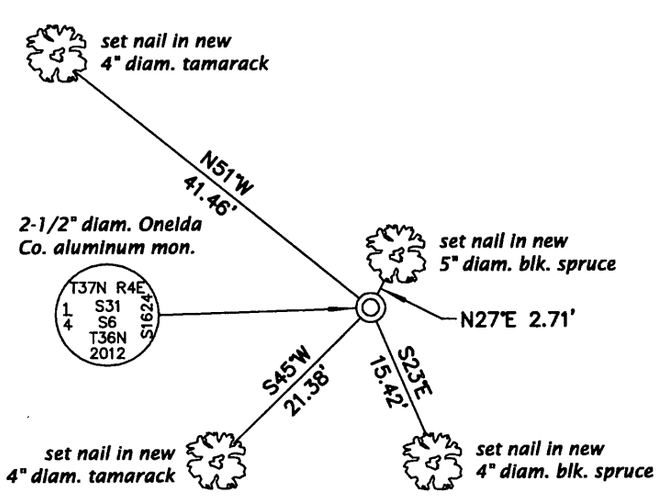

NO SCALE

REGISTER OF DEEDS OFFICE
ONEIDA COUNTY
FILED

APR 15 2013

AT_____O'CLOCK_____M
KYLE J. FRANSON
REGISTER OF DEEDS

(i) I, Michael J. Romportl, Registered Land Surveyor No. S-1624, hereby certify that the corner location on this record was determined by me or under my direction and control and that this U.S. Public Land Survey Monument Record is correct and complete to the best of my knowledge and belief.

WISCONSIN
MICHAEL J. ROMPORTL
S-1624
RHINELANDER, WI
LAND SURVEYOR

Michael J Romportl 2/12/2013
Signature Date

3704310020 (INDEX NO. Z-3)